
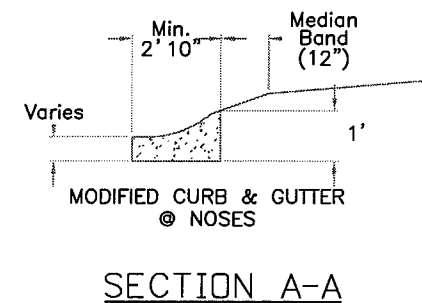
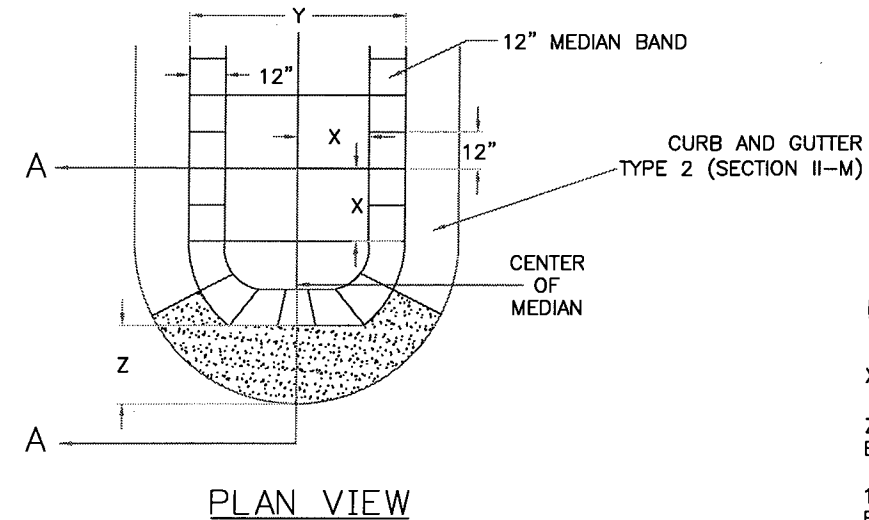


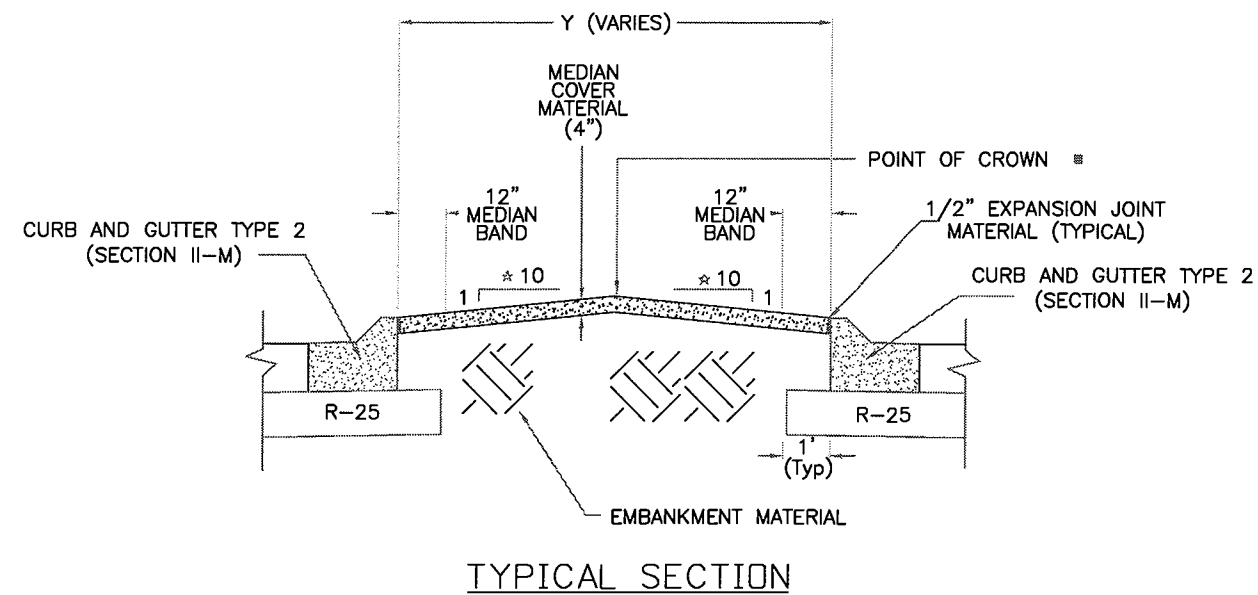

NOTES:

$X = (Y-2)/2$ (FT.)

Z = 2', MEDIAN NOSES SHALL BE SLOPED APPROX. 2 FT. BACK FROM END OF PAN.

1/2" EXPANSION JOINT MATERIAL SHALL BE PLACED BETWEEN BACK OF CURB AND MEDIAN COVER MATERIAL. SAME MATERIAL SHALL BE PLACED EVERY 200' COINCIDING WITH CONTROL JOINTS.

MEDIAN COVER SHALL HAVE A 12" WIDE OUTSIDE BAND AGAINST BACK OF CURB, AS SHOWN.

ALL MEDIAN COVER COLOR SHALL BE FEDERAL STANDARD 5958 COLOR 20206 (DAVIS TILE RED) OR AN APPROVED EQUAL.

PROVIDE 6" DIAMETER PVC BLOCKOUTS IN MEDIAN CONCRETE FOR DELINEATORS. THE COST OF THE SLEEVE AND PATCHING WILL NOT BE PAID FOR SEPARATELY, BUT INCLUDED IN THE COST OF ITEM 612, DELINEATORS. (SEE DELINEATOR TABULATION)

- CROWN SHALL BE ROUNDED.
- ☆ CROSS-SLOPE OF MEDIAN COVER MAY VARY AS DIRECTED BY ENGINEER.

GROOVED DIMENSIONS:
WIDTH = APPROX. 1/4" DEPTH = APPROX. 1/2"

CONTROL JOINTS SHALL BE PLACED EVERY 10 FT. OR AS DIRECTED BY THE ENGINEER AT A MINIMUM DEPTH OF 1".

Print Date: 10/13/2010		0000	Sheet Revisions			Colorado Department of Transportation		As Constructed		MEDIAN COVER DETAIL			Project No./Code	
Drawing File Name: 14976MedianCoverDetails.dgn			Date:	Comments	Init.	 Arapahoe Residency 7328 S. Revere Parkway, Suite 204A Centennial, CO 80112 Phone: 303-365-7230 FAX: 303-790-1037	No Revisions: 4/23/2012		Designer: JJB Structure Numbers Detailer: JJB			STA 086A-047		
Horiz. Scale: 1:1 Vert. Scale: As Noted							Revised:					16275		
Unit Information RYJ							Void:		Sheet Subset: MedianCov Subset Sheets: 1 of 1		Sheet Number 62			
							Region 1 RYJ							