

NO CHANGES ARE TO BE MADE TO THIS DRAWING WITHOUT WRITTEN PERMISSION OF HARRIS KOCHER SMITH.

LEGAL DESCRIPTION

LOT 1, BLOCK 4 OF BRICKYARD FILING NO. 1, RECORDED AT RECEPTION NO. _____
TOWN OF CASTLE ROCK, COUNTY OF DOUGLAS, STATE OF COLORADO.

BENCHMARK

BENCHMARK IS NGS POINT G 23, BEING A STANDARD BENCHMARK DISK IN TOP OF CONCRETE POST, ELEVATION = 6231.61 NVAD88.

BASIS OF BEARINGS

BEARINGS ARE BASED ON THE WEST LINE OF THE NORTHEAST QUARTER OF SECTION 11, TOWNSHIP 8 SOUTH, RANGE 67 WEST OF THE 6TH PRINCIPLE MEDIAN. AS MONUMENTED AT THE NORTHWEST CORNER BY A REBAR W/ 2.5": ALUM. CAP PLS 6935 AMD AT TJE WEST QUARTER CORNER BY A 1" STEEL RODE W/ 2" CAP PIPE PLS 6935 AS BEARING NORTH 00°25'11" WEST, AS SHOWN ON THE PLAT OF CITADEL STATION FILING NO. 6.

GENERAL NOTES

1. ALL MATERIALS, WORKMANSHIP, AND CONSTRUCTION OF PUBLIC IMPROVEMENTS SHALL MEET OR EXCEED THE STANDARDS AND SPECIFICATIONS SET FORTH IN THE TOWN OF CASTLE ROCK (TCR) MUNICIPAL CODE, TCR TECHNICAL MANUALS, AND APPLICABLE STATE AND FEDERAL REGULATIONS. WHERE THERE IS CONFLICT BETWEEN THESE PLANS AND THE TECHNICAL MANUAL OR ANY APPLICABLE STANDARDS, THE MORE STRINGENT STANDARD SHALL APPLY. ALL WORK SHALL BE INSPECTED AND APPROVED BY THE TCR CONSTRUCTION INSPECTOR.

2. THE CONTRACTOR IS SPECIFICALLY CAUTIONED THAT THE LOCATION AND/OR ELEVATION OF EXISTING UTILITIES AS SHOWN ON THESE PLANS IS BASED ON RECORDS OF THE VARIOUS UTILITY COMPANIES AND, WHERE POSSIBLE, MEASUREMENTS TAKEN IN THE FIELD. THE INFORMATION IS NOT TO BE RELIED UPON AS BEING EXACT OR COMPLETE.

3. THE CONTRACTOR MUST CALL THE LOCAL UTILITY LOCATION CENTER AT LEAST 72 HOURS BEFORE ANY EXCAVATION TO REQUEST EXACT FIELD LOCATIONS OF THE UTILITIES. PRIOR TO CONSTRUCTION, THE CONTRACTOR SHALL VERIFY PERTINENT LOCATIONS AND ELEVATIONS, ESPECIALLY AT CONNECTION POINTS AND AT POTENTIAL UTILITY CONFLICTS. IT SHALL BE THE RESPONSIBILITY OF THE CONTRACTOR TO RELOCATE ALL EXISTING UTILITIES THAT CONFLICT WITH THE PROPOSED IMPROVEMENTS SHOWN ON THESE PLANS.

4. THE CONTRACTOR SHALL COORDINATE AND COOPERATE WITH THE TOWN AND ALL UTILITY COMPANIES INVOLVED WITH REGARD TO RELOCATIONS OR ADJUSTMENTS OF EXISTING UTILITIES DURING CONSTRUCTION AND TO ASSURE THAT THE WORK IS ACCOMPLISHED IN A TIMELY FASHION AND WITH A MINIMUM DISRUPTION OF SERVICE. THE CONTRACTOR SHALL BE RESPONSIBLE FOR CONTACTING ALL PARTIES AFFECTED BY ANY DISRUPTION OF ANY UTILITY SERVICE.

5. CONTRACTOR SHALL PROVIDE A MINIMUM SEVENTY-TWO (72) HOURS NOTICE TO THE ON-SITE TCR CONSTRUCTION INSPECTOR, (720) 733-2200, PRIOR TO MAKING ANY CONNECTIONS/TIE-INS TO EXISTING WATER, SANITARY SEWER, AND/OR STORM SEWER SYSTEMS PROVIDED THAT THE UTILITY TIE-IN DOES NOT DISRUPT SERVICE TO EXISTING OR WATER CUSTOMERS. IF THE TIE-IN WILL DISRUPT UTILITY SERVICE, THEN CONTRACTOR SHALL PROVIDE A MINIMUM OF THREE (3) WEEKS NOTICE TO THE TCR CONSTRUCTION INSPECTOR TO ALLOW TIME FOR CR WATER TO PROVIDE WRITTEN NOTIFICATION TO EXISTING CUSTOMERS AFFECTED BY THE TIE-IN. ALL TOWN UTILITY TIE-INS MUST BE APPROVED BY CR WATER PRIOR TO COMMENCING WORK.

6. THE CONTRACTOR SHALL HAVE ONE (1) SIGNED COPY OF THE APPROVED PLANS, ONE (1) COPY OF THE APPROPRIATE CRITERIA AND SPECIFICATIONS, AND A COPY OF ANY PERMITS AND EXTENSION AGREEMENTS NEEDED FOR THE JOB ONSITE AT ALL TIMES.

7. THE CONTRACTOR SHALL BE RESPONSIBLE FOR ALL ASPECTS OF SAFETY INCLUDING, BUT NOT LIMITED TO, EXCAVATION, TRENCHING, SHORING, TRAFFIC CONTROL, AND SECURITY.

8. IF DURING THE CONSTRUCTION PROCESS CONDITIONS ARE ENCOUNTERED WHICH COULD INDICATE A SITUATION THAT IS NOT IDENTIFIED IN THE PLANS OR SPECIFICATIONS, THE CONTRACTOR SHALL CONTACT THE TCR CONSTRUCTION INSPECTOR IMMEDIATELY.

9. ALL REFERENCES TO ANY PUBLISHED STANDARDS SHALL REFER TO THE LATEST REVISION OF SAID STANDARD UNLESS SPECIFICALLY STATED OTHERWISE.

10. THE CONTRACTOR SHALL SUBMIT A TRAFFIC CONTROL PLAN IN ACCORDANCE WITH MUTCD TO THE APPROPRIATE RIGHT-OF-WAY AUTHORITY (TOWN, COUNTY OR STATE) FOR APPROVAL PRIOR TO ANY CONSTRUCTION ACTIVITIES WITHIN OR AFFECTING THE RIGHT-OF-WAY. THE CONTRACTOR SHALL BE RESPONSIBLE FOR PROVIDING ANY AND ALL TRAFFIC CONTROL DEVICES AS MAY BE REQUIRED BY THE CONSTRUCTION ACTIVITIES.

11. THE CONTRACTOR IS RESPONSIBLE FOR PROVIDING ALL LABOR AND MATERIALS NECESSARY FOR THE COMPLETION OF THE INTENDED IMPROVEMENTS SHOWN ON THESE DRAWINGS OR AS DESIGNATED TO BE PROVIDED, INSTALLED, OR CONSTRUCTED UNLESS SPECIFICALLY NOTED OTHERWISE.

12. THE CONTRACTOR SHALL BE RESPONSIBLE FOR RECORDING AS-BUILT INFORMATION ON A SET OF RECORD DRAWINGS KEPT ON THE CONSTRUCTION SITE AND AVAILABLE TO THE TCR CONSTRUCTION INSPECTOR AT ALL TIMES.

13. DIMENSIONS FOR LAYOUT AND CONSTRUCTION ARE NOT TO BE SCALED FROM ANY DRAWING. IF PERTINENT DIMENSIONS ARE NOT SHOWN, CONTACT THE CONSULTANT ENGINEER FOR CLARIFICATION AND ANNOTATE THE DIMENSION ON THE AS-BUILT RECORD DRAWINGS.

14. ALL INITIAL SEDIMENT CONTROL MEASURES SHALL BE INSTALLED PER THE TEMPORARY EROSION & SEDIMENT CONTROL (TESC) PLAN PRIOR TO ANY EARTH-DISTURBING ACTIVITY. ALL EROSION AND SEDIMENT CONTROL PRACTICES MUST BE MAINTAINED IN EFFECTIVE OPERATING CONDITION AT ALL TIMES. REMOVAL OF CONTROL MEASURES SHALL NOT OCCUR WITHOUT THE APPROVAL OF THE STORMWATER INSPECTOR. THE CONTRACTOR SHALL BE RESPONSIBLE FOR KEEPING ROADWAYS FREE AND CLEAR OF ALL CONSTRUCTION DEBRIS AND DIRT TRACKED FROM THE SITE. THE CONTRACTOR SHALL ALSO COMPLY WITH ALL TERMS AND CONDITIONS OF THE COLORADO CONSTRUCTION GENERAL PERMIT FOR STORMWATER DISCHARGES.

15. THE CONTRACTOR SHALL PROVIDE AN ACTION PLAN IMMEDIATELY FOLLOWING THE

PRE-CONSTRUCTION MEETING DETAILING SUFFICIENT MEANS TO MITIGATE DUST ON SITE DURING OVERLOT GRADING, ROCK CRUSHING OR OTHER EARTHWORK ACTIVITIES. IF THE CONTRACTOR FAILS TO CONTROL DUST, ALL EARTH DISTURBING ACTIVITIES SHALL BE STOPPED UNTIL SUFFICIENT MEASURES ARE TAKEN TO THE TOWN'S SATISFACTION. THE CONTRACTOR SHALL ALSO COMPLY WITH ALL TERMS AND CONDITIONS OF THE COLORADO AIR QUALITY REGULATIONS FOR LAND DEVELOPMENT, AS REQUIRED.

16. THE CONTRACTOR SHALL SEQUENCE INSTALLATION OF UTILITIES IN SUCH A MANNER AS TO MINIMIZE POTENTIAL UTILITY CONFLICTS. IN GENERAL, STORM SEWER AND SANITARY SEWER SHOULD BE CONSTRUCTED PRIOR TO INSTALLATION OF THE WATER LINES AND DRY UTILITIES.

17. THERE SHALL BE NO SITE CONSTRUCTION ACTIVITIES ON SATURDAYS UNLESS SPECIFICALLY APPROVED BY THE TCR CONSTRUCTION INSPECTOR AND NO SITE CONSTRUCTION ACTIVITIES ON SUNDAYS OR HOLIDAYS UNLESS THERE IS PRIOR WRITTEN APPROVAL BY THE PUBLIC WORKS DIRECTOR.


18. NO SOLID OBJECT (EXCLUDING FIRE HYDRANTS AND TRAFFIC CONTROL DEVICES AND TRAFFIC SIGNS) EXCEEDING THIRTY (30) INCHES IN HEIGHT ABOVE THE FLOWLINE ELEVATION OF THE ADJACENT STREET, INCLUDING BUT NOT LIMITED TO BUILDINGS, UTILITY CABINETS, WALLS, FENCES, LANDSCAPE PLANTINGS, CROPS, CUT SLOPES, AND BERMS, SHALL BE PLACED WITHIN SIGHT DISTANCE LINES AND SIGHT DISTANCE EASEMENTS.

19. THIS PROPERTY IS LOCATED WITHIN ZONE X AS PER FEMA FIRM PANEL NO. 0306G DATED 03-16-2016.

20. FUTURE (FUTR) UTILITIES AND ROADWAY IMPROVEMENTS SHOWN IN THIS PLAN SET WILL BE INSTALLED BY OTHERS (UNDER A SEPARATE CONTRACT) AS PART OF THE CD24-0030 PLAN SET.

FIRE NOTE:

1. THE TOWN OF CASTLE ROCK FIRE DEPARTMENT APPROVED THE VARIANCE REQUEST FOR ENTRY SEPARATION ON 09/19/23. REFER TO TCV23-0042 FOR ADDITIONAL INFORMATION.

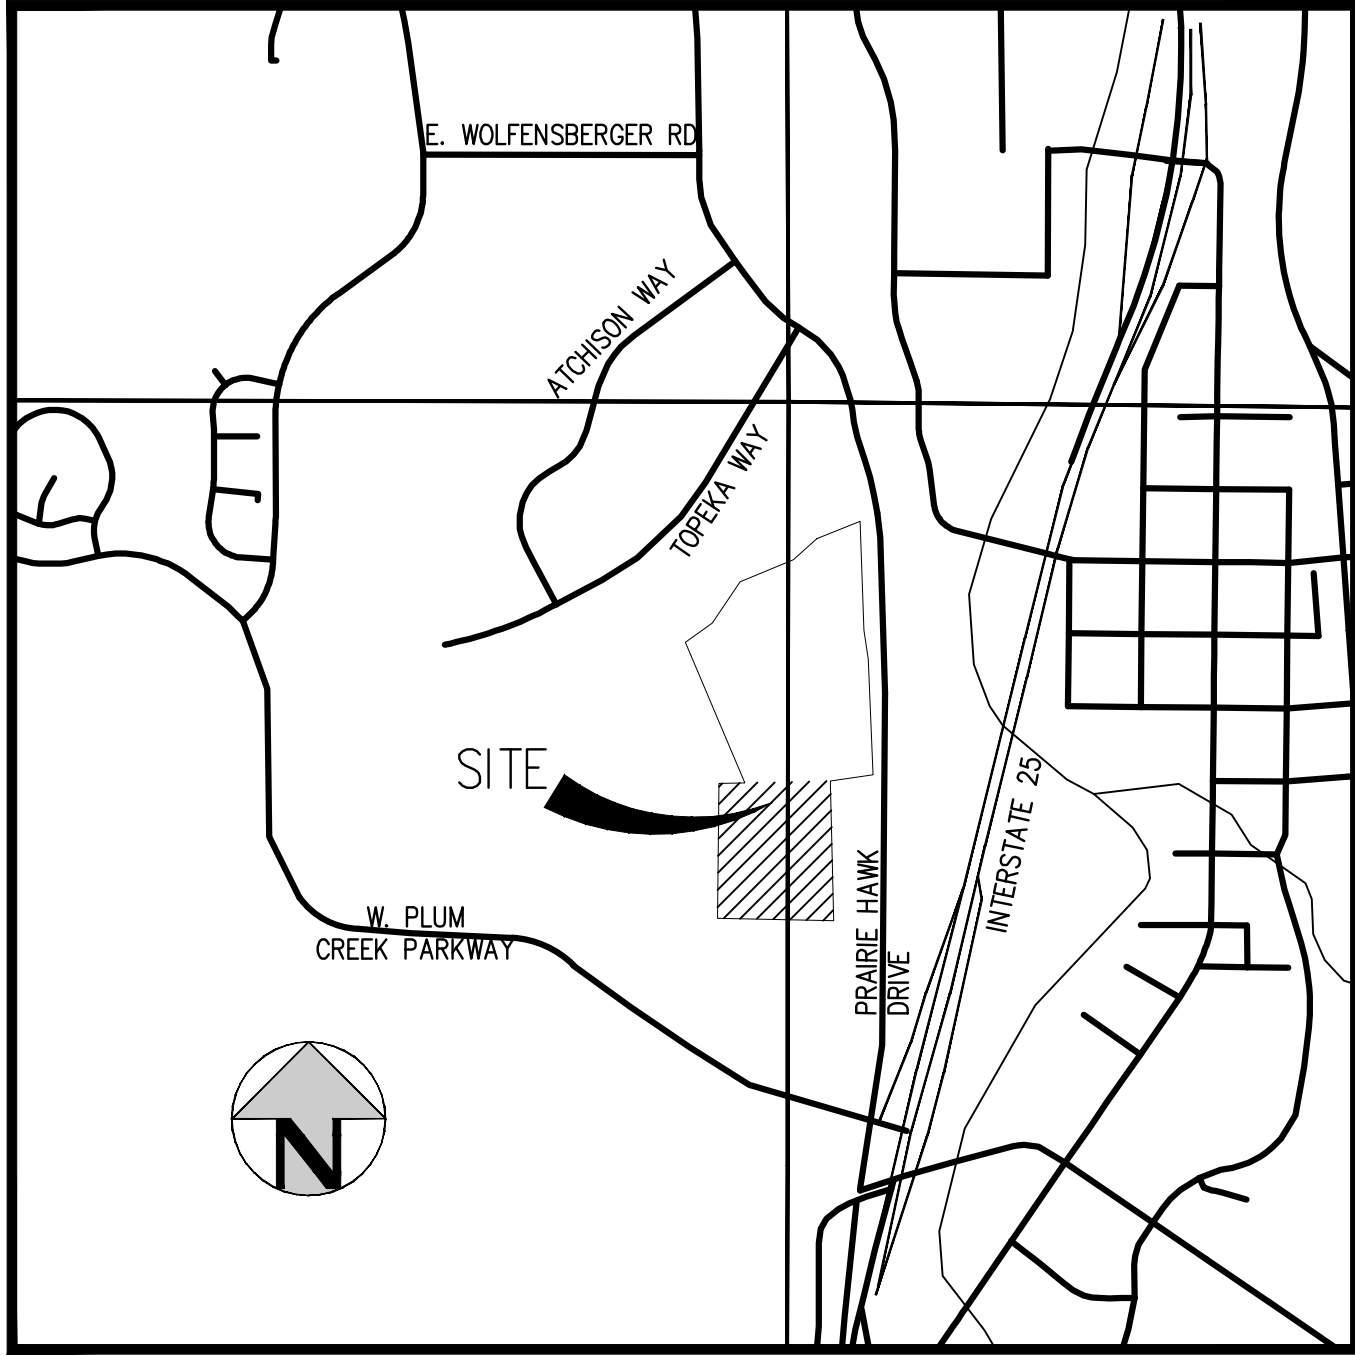

VICINITY MAP

SCALE: 1" = 1000'

SHEET INDEX

CD1	COVER SHEET
CD2	GENERAL NOTES
CD3	SITE PLAN
CD4	OVERALL UTILITY PLAN
CD5	OVERALL GRADING PLAN
CD6	SIGNAGE AND STRIPING PLAN
CD7	PAVING PLAN
CD8	DETAILED GRADING PLAN
CD9	DETAILED GRADING PLAN
CD10	DETAILED GRADING PLAN
CD11	DETAILED GRADING PLAN
CD12	DETAILED GRADING PLAN
CD13	DETAILED GRADING PLAN
CD14	DETAILED GRADING PLAN
CD15	DETAILED GRADING PLAN
CD16	DETAILED GRADING PLAN
CD17	DETAILED GRADING PLAN
CD18	DETAILED GRADING PLAN
CD19	NORTH TURF SUBSURFACE DETAILED GRADING PLAN
CD20	SOUTH TURF SUBSURFACE DETAILED GRADING PLAN
CD21	STORM LINES E (DOWNSTREAM) & EA
CD22	STORM LINE E (UPSTREAM)
CD23	STORM LINES EC & EE
CD24	STORM LINES F, FA, & FB PLAN & PROFILE
CD25	LANDSCAPE DRAIN PLAN
CD26	LANDSCAPE DRAIN PLAN
CD27	SANITARY SEWER LINE A PLAN & PROFILE
CD28	SANITARY SEWER SERVICE PLAN & PROFILE
CD29	WATER PLAN & PROFILE
CD30	WATER PLAN & PROFILE
CD31	WATER PLAN & PROFILE
CD32	GENERAL DETAILS
CD33	GENERAL DETAILS
CD34	STORM SEWER DETAILS
CD35	LANDSCAPE DRAIN DETAILS
CD36	WATER DETAILS
CD37	WATER DETAILS
CD38	WATER DETAILS
CD39	SANITARY SEWER DETAILS

ABBREVIATIONS	
BLDG	BUILDING
BOP	BOTTOM OF PIPE
BS	BOTTOM OF STEP
BW	BOTTOM OF WALL (FG)
CONC	CONCRETE
DIA	DIAMETER
DIP	DUCTILE IRON PIPE
DR	DOOR
DS	DOWNSPOUT
E	EAST, EASTING
EGL	ENERGY GRADE LINE
EL	ELEVATION
EOA	EDGE OF ASPHALT
EOC	EDGE OF CONCRETE
EOP	EDGE OF PAVEMENT
ESMT	EASEMENT
EV	ELECTRIC VEHICLE
EX	EXISTING
FDC	FIRE DEPARTMENT CONNECTION
FF	FINISHED FLOOR
FG	FINISHED GRADE
FH	FIRE HYDRANT
FL	FLOW LINE
FO	FIBER OPTIC
FUTR	FUTURE
GB	GRADE BREAK
GV	GATE VALVE
HC	HANDICAP
HGL	HYDRAULIC GRADE LINE
HP	HIGH POINT
IR	IRRIGATION
INV	INVERT
LP	LOW POINT
LSD	LANDSCAPE DRAIN
MAX	MAXIMUM
MH	MANHOLE
MIN	MINIMUM
MJ	MECHANICAL JOINT
N	NORTH, NORTHING
PR	PROPOSED
PVC	POLYVINYL CHLORIDE
RCP	REINFORCED CONCRETE PIPE
ROW	RIGHT OF WAY
SAN	SANITARY
SS	SANITARY SEWER
STA	STATION
STM	STORM
SW	SIDEWALK
TB	THRUST BLOCK
TBC	TOPIBACK OF CURB
TKC	TYPE K COPPER
TOP	TOP OF PIPE
TS	TOP OF STEP
TW	TOP OF WALL (FG)
TYP	TYPICAL
UGE	UNDERGROUND ELECTRIC
VERT	VERTICAL
WAT	WATER
XING	CROSSING

LEGEND

	EXISTING	PROPOSED
PROPERTY BOUNDARY	---	---
RIGHT-OF-WAY	---	---
UTILITY EASEMENT	---	---
ACCESS EASEMENT	---	---
ACCESSIBLE ROUTE	●●●●●●●●	●●●●●●●●
SANITARY SEWER W/ MANHOLE	SS	SS
SANITARY SERVICE W/CLEANOUT	SS	SS
WATER LINE AND GATE VALVE	W	W
WATER SERVICE	---	---
STORM SEWER W/ MANHOLE & INLETS	ST	ST
WATER METER MANHOLE		
FIRE HYDRANT		
STREET LIGHT		
SIGN		
FENCE		
TRANSFORMER		

PROFESSIONAL ENGINEER CERTIFICATION

I HEREBY AFFIRM THAT THESE FINAL CONSTRUCTION PLANS WERE PREPARED UNDER MY DIRECT SUPERVISION, IN ACCORDANCE WITH ALL APPLICABLE TOWN OF CASTLE ROCK AND STATE OF COLORADO STANDARDS AND STATUTES, RESPECTIVELY; AND THAT I AM FULLY RESPONSIBLE FOR ALL DESIGN AND REVISIONS RELATIVE TO SAID PLANS.

PRELIMINARY
NOT FOR
CONSTRUCTION

JOHN D O'ROURKE, P.E. #43327 DATE

INDEMNIFICATION AND ADHERENCE TO STANDARDS STATEMENTS

THESE PLANS HAVE BEEN REVIEWED BY THE TOWN OF CASTLE ROCK FOR CONCEPT ONLY. THE REVIEW DOES NOT IMPLY RESPONSIBILITY BY THE REVIEWING DEPARTMENT, THE TOWN ENGINEER, OR THE TOWN OF CASTLE ROCK FOR ACCURACY AND CORRECTNESS OF THE CALCULATIONS. FURTHERMORE, THE REVIEW DOES NOT IMPLY THAT QUANTITIES OF ITEMS ON THE PLANS ARE THE FINAL QUANTITIES REQUIRED. THE REVIEW SHALL NOT BE CONSTRUED FOR ANY REASON AS ACCEPTANCE OF FINANCIAL RESPONSIBILITY BY THE TOWN FOR ADDITIONAL QUANTITIES OF ITEMS SHOWN THAT MAY BE REQUIRED DURING THE CONSTRUCTION PHASE.

ALL WORK SHALL BE CONSTRUCTED IN ACCORDANCE WITH THE TOWN OF CASTLE ROCK MUNICIPAL CODE, TECHNICAL MANUALS AND/OR OTHER TOWN-APPROVED APPLICABLE STANDARDS.

TOWN OF CASTLE ROCK APPROVAL

PLANS ARE HEREBY APPROVED FOR ONE YEAR FROM DATE OF DEVELOPMENT SERVICES APPROVAL

Approved By:

Development Services Date

TOWN OF CASTLE ROCK PUBLIC WORK DEPARTMENT

4175 N. CASTLETON COURT
CASTLE ROCK, CO 80109
P: 720.733.2462
EMAIL: MCAMALLER@CRGOV.COM

CASTLE ROCK WATER

175 KELLOGG COURT CASTLE
ROCK, CO 80109
P: 720.733.6000
EMAIL: WATER@CRGOV.COM

DEVELOPER/CURRENT OWNER



430 INDIANA STREET SUITE 200
GOLDEN, CO 20401
P: 303.328.8093
POC: DAN TOVADO
DTOVADO@CONFLUENCECO.COM

ARCHITECT



990 S BROADWAY SUITE 222
DENVER, CO 80209
P: 303.455.1366
POC: MELISSA FORD
MELISSAFORD@BRSARCH.COM

LANDSCAPE ARCHITECT



1510 YORK STREET SUITE 302
DENVER, CO 80206
P: 720.236.6656
POC: NATHAN KROHN
NATHAN@BACK40LA.COM

CIVIL ENGINEER





1120 LINCOLN STREET, SUITE 1000
DENVER, COLORADO 80203
P: 303.623.6300 F: 303.623.6311
HARRIS.KOCHER@HKS.COM
POC: LIBBEY ENDERSBE
LENDERSBE@HKS.ENG.COM

ISSUE DATE: 05-24-2024	PROJECT #: 200726
DATE	REVISION COMMENTS
06-04-2024	30% CD
07-31-2024	60% CD
08-30-2024	70% CD
10-02-2024	95% CD
10-22-2024	PRICING SET
11-08-2024	TOWN SUBMITTAL


NO CHANGES ARE TO BE MADE TO THIS DRAWING WITHOUT WRITTEN PERMISSION OF HARRIS KOCHER SMITH.

FILE PATH: P:\2020\2020\ENGINEERING\OUTLINES\REC CENTERCD - OVERALL UTILITY PLAN.DWG LAYOUT LAYOUT
16-SEP-2024 10:56:58 AM
PLOTTED: FR 11/08/24 13:13:39 BY: LIBBY ENDERSS

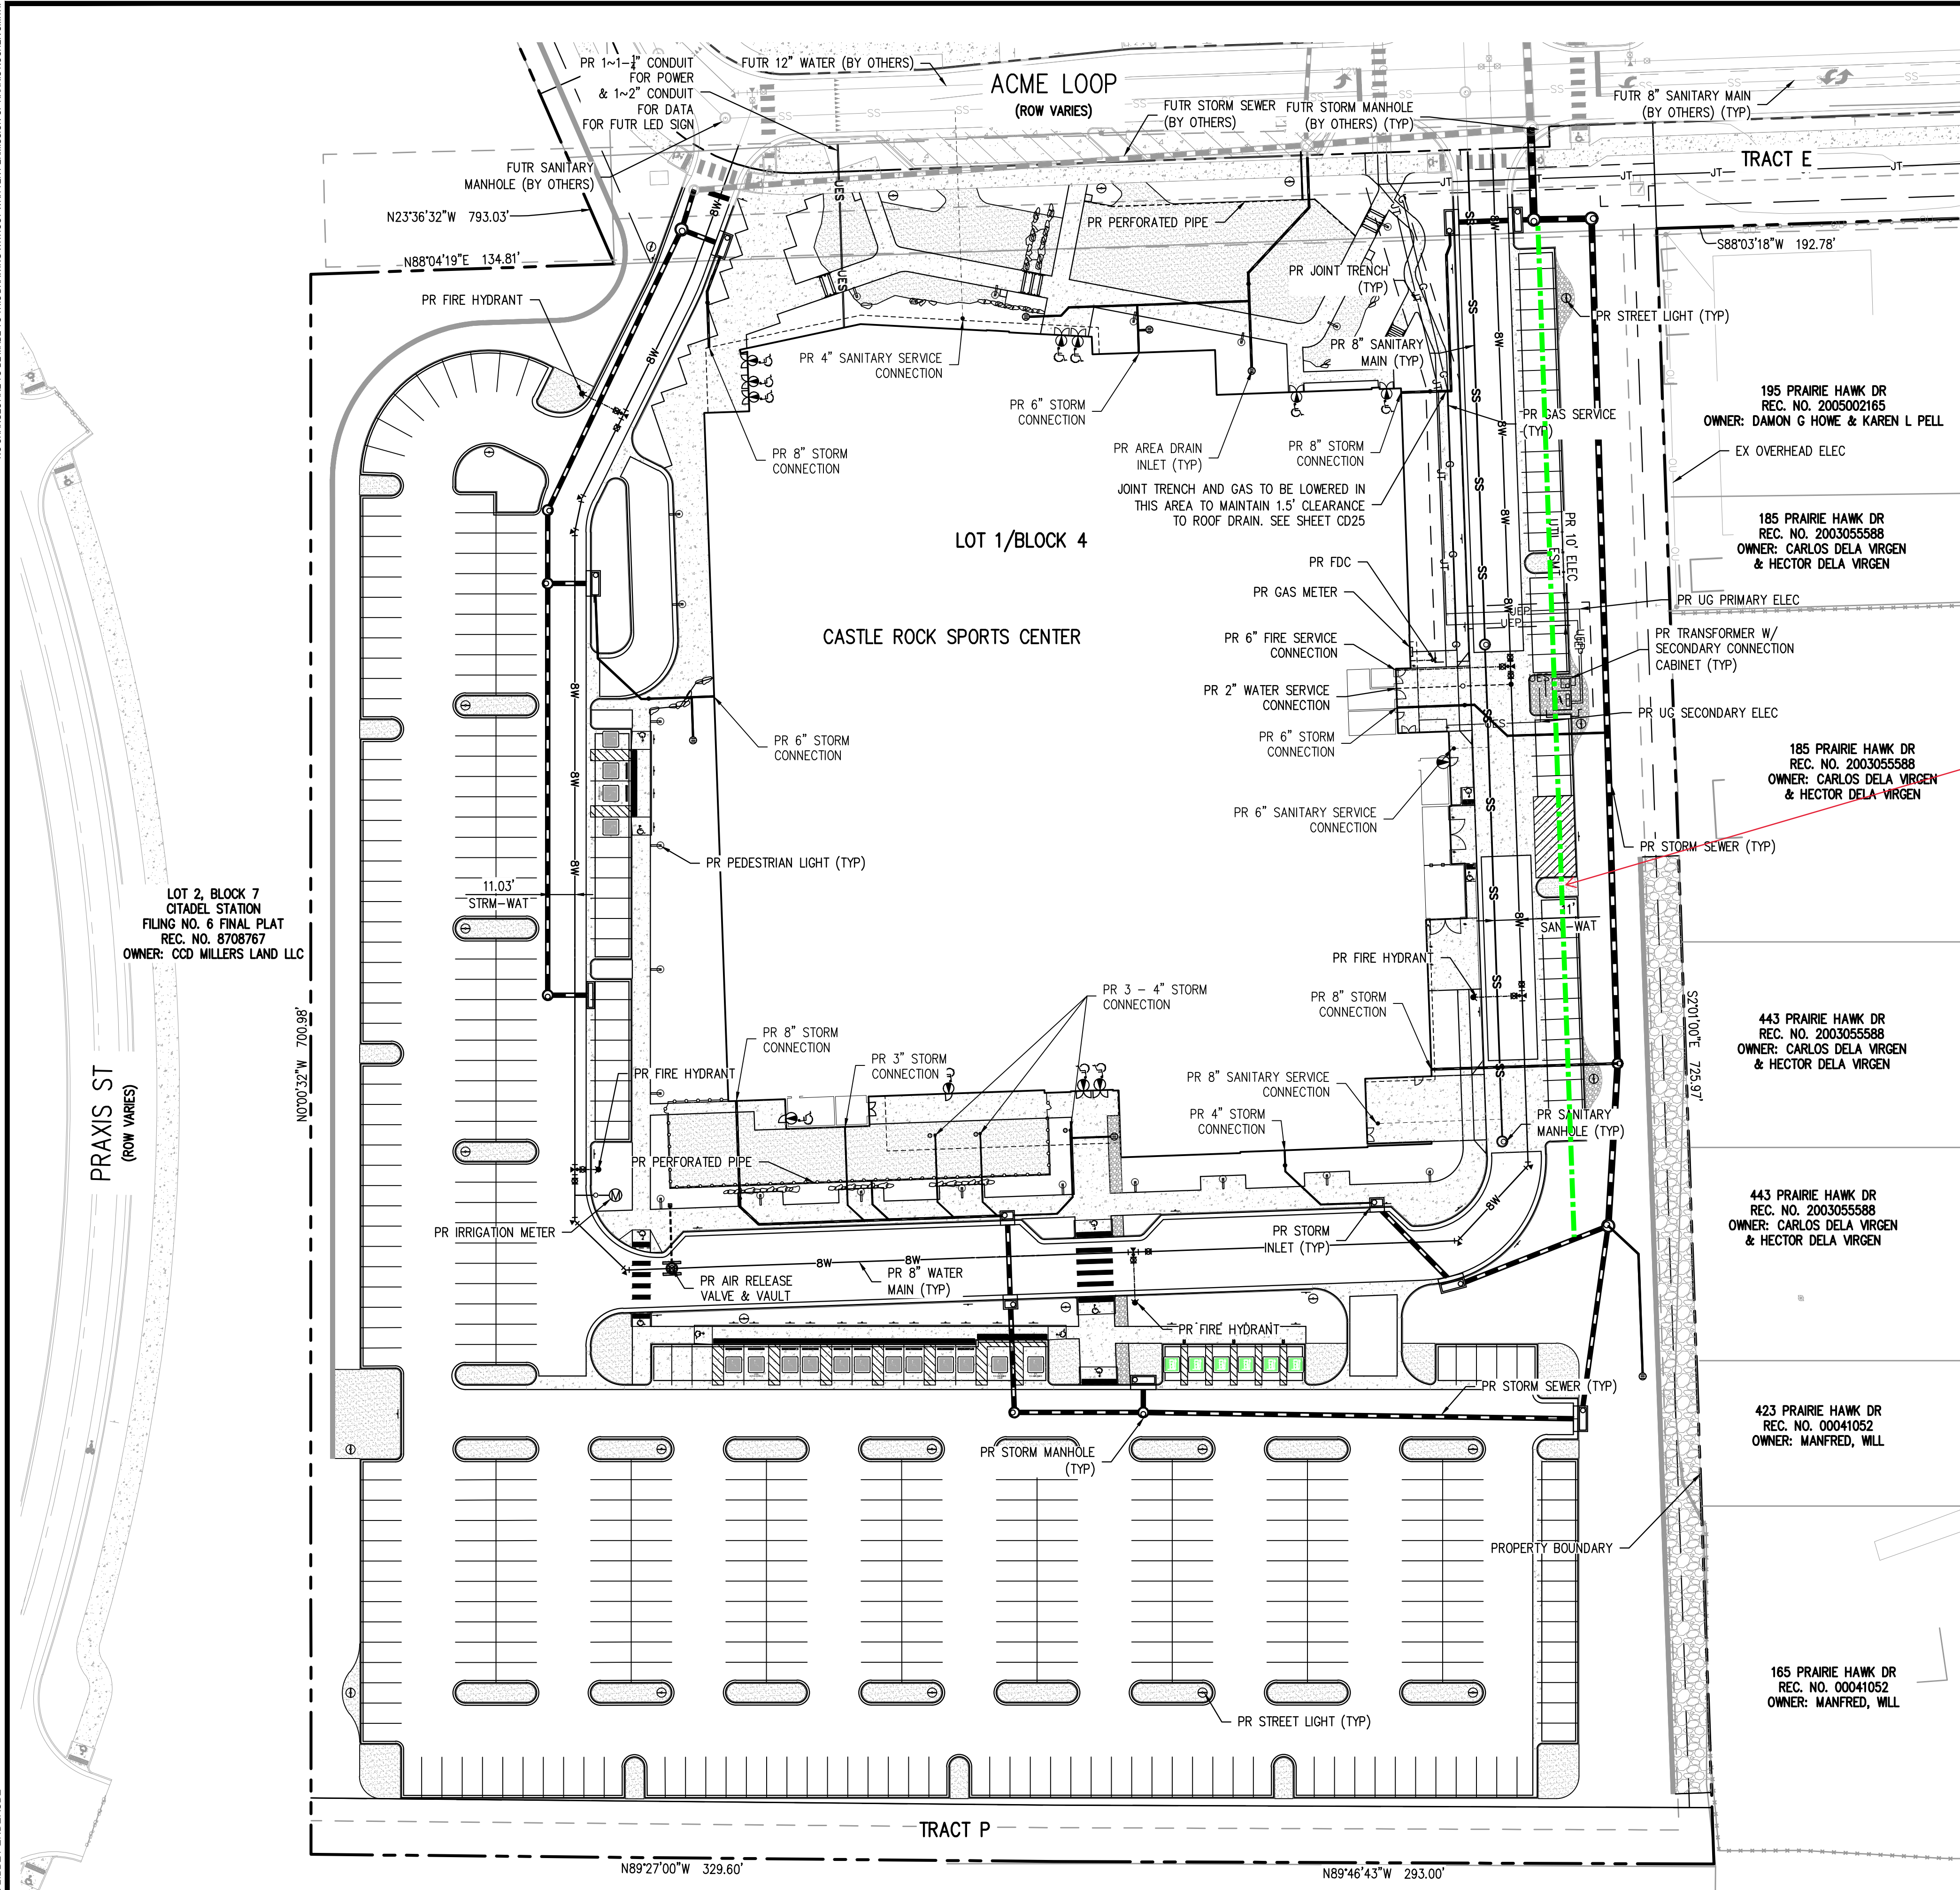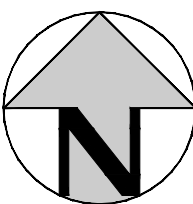

LEGEND:

- PROPERTY BOUNDARY
- EXISTING SANITARY SEWER
- EXISTING WATER LINE
- EXISTING STORM LINE
- PROPOSED LANDSCAPE DRAIN PIPE
- PROPOSED LANDSCAPE AREA DRAIN
- PROPOSED SANITARY SEWER W/ MANHOLE
- PROPOSED WATER LINE
- PROPOSED WATER SERVICE
- PROPOSED FIRE SERVICE
- PROPOSED SANITARY SERVICE
- PROPOSED STORM LINE
- PROPOSED GAS LINE
- PROPOSED ELECTRIC LINE
- PROPOSED RETAINING WALL
- PROPOSED HYDRANT
- PROPOSED STREET LIGHT
- PROPOSED PEDESTRIAN LIGHT
- PROPOSED TRANSFORMER

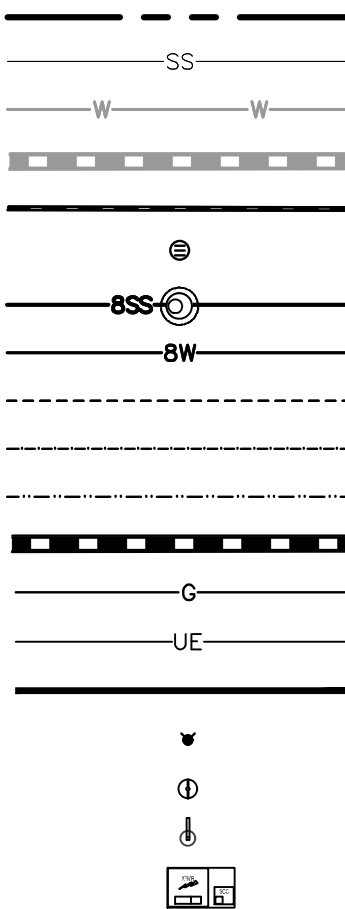

VERTICAL DATUM

NGS POINT G 23, BEING A STANDARD BENCHMARK DISK IN TOP OF CONCRETE POST, ELEVATION = 6231.61 NAVD88

HORIZONTAL CONTROL


BEARINGS ARE BASED ON THE WEST LINE OF THE NORTHWEST QUARTER OF SECTION 11, TOWNSHIP 8 SOUTH, RANGE 67 WEST OF THE 6TH PRINCIPAL MERIDIAN. AS MONUMENTED AT THE NORTHWEST CORNER BY A REBAR W/ 2.5" ALUM. CAP PLS 6935 AND AT THE WEST QUARTER CORNER BY A 1" STEEL ROPE W/ 2" CAP PIPE PLS 6935 AS BEARING NORTH 0025°11' WEST, AS SHOWN ON THE PLAT OF CITADEL STATION FILING NO. 6.

PROFESSIONAL ENGINEER CERTIFICATION

I HEREBY AFFIRM THAT THESE FINAL CONSTRUCTION PLANS WERE PREPARED UNDER MY DIRECT SUPERVISION, IN ACCORDANCE WITH ALL APPLICABLE TOWN OF CASTLE ROCK AND STATE OF COLORADO STANDARDS AND STATUTES, RESPECTIVELY; AND THAT I AM FULLY RESPONSIBLE FOR ALL DESIGN AND REVISIONS RELATIVE TO SAID PLANS.

PRELIMINARY
NOT FOR
CONSTRUCTION

JOHN D O'ROURKE, P.E. #43327	DATE
TOWN OF CASTLE ROCK APPROVAL	
PLANS ARE HEREBY APPROVED FOR ONE YEAR FROM DATE OF DEVELOPMENT SERVICES APPROVAL	
Approved By:	
Development Services	Date

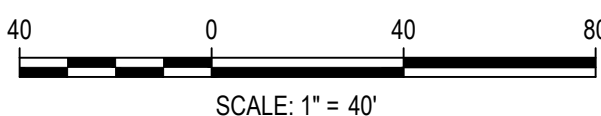

DESIGNED BY: AS
CHECKED BY: JDO
DRAWN BY: AS

ISSUE DATE: 05-24-2024	
DATE	REVISION COMMENTS
06-04-2024	30% CD
07-31-2024	60% CD
08-30-2024	70% CD
10-02-2024	95% CD
10-22-2024	PRICING SET
11-08-2024	TOWN SUBMITTAL



HKS HARRIS KOCHER SMITH
1120 Lincoln Street, Suite 1000
Denver, Colorado 80203
P: 303.623.6300 F: 303.623.6311
HarrisKocherSmith.com

CONFLUENCE COMPANIES, LLC

CASTLE ROCK SPORT CENTER
OVERALL UTILITY PLAN

PROJECT #: 200726
SHEET NUMBER

CD4

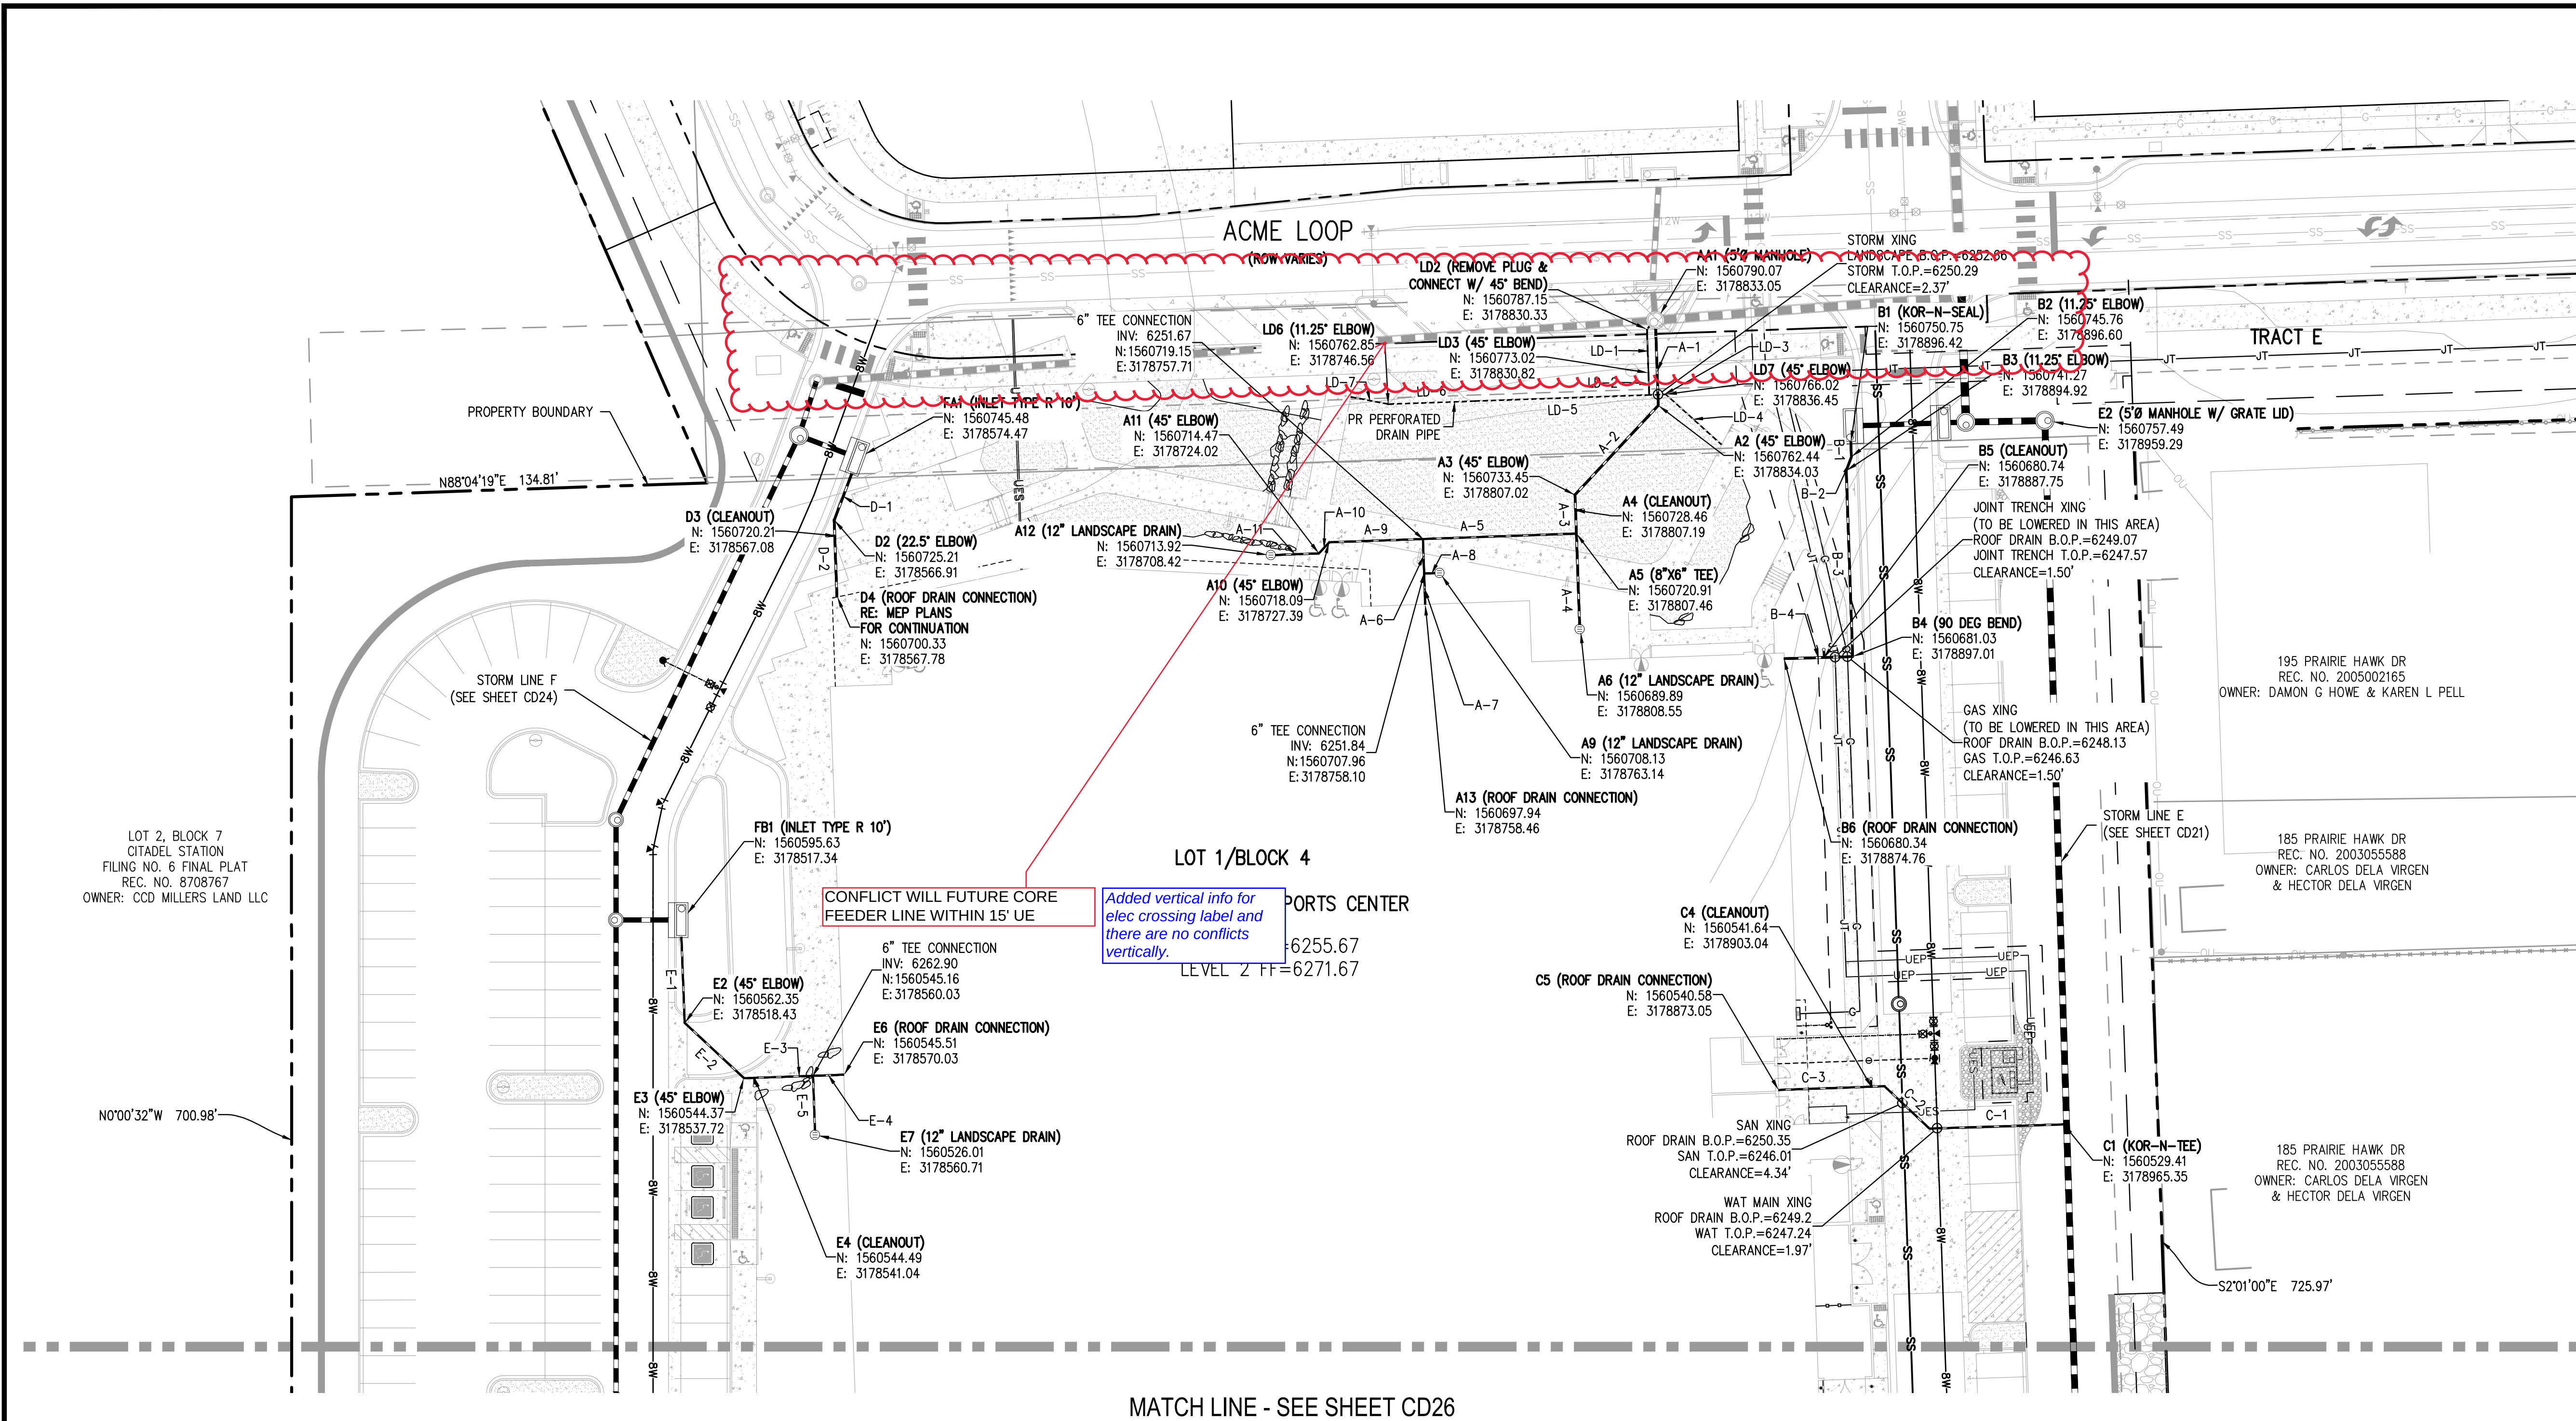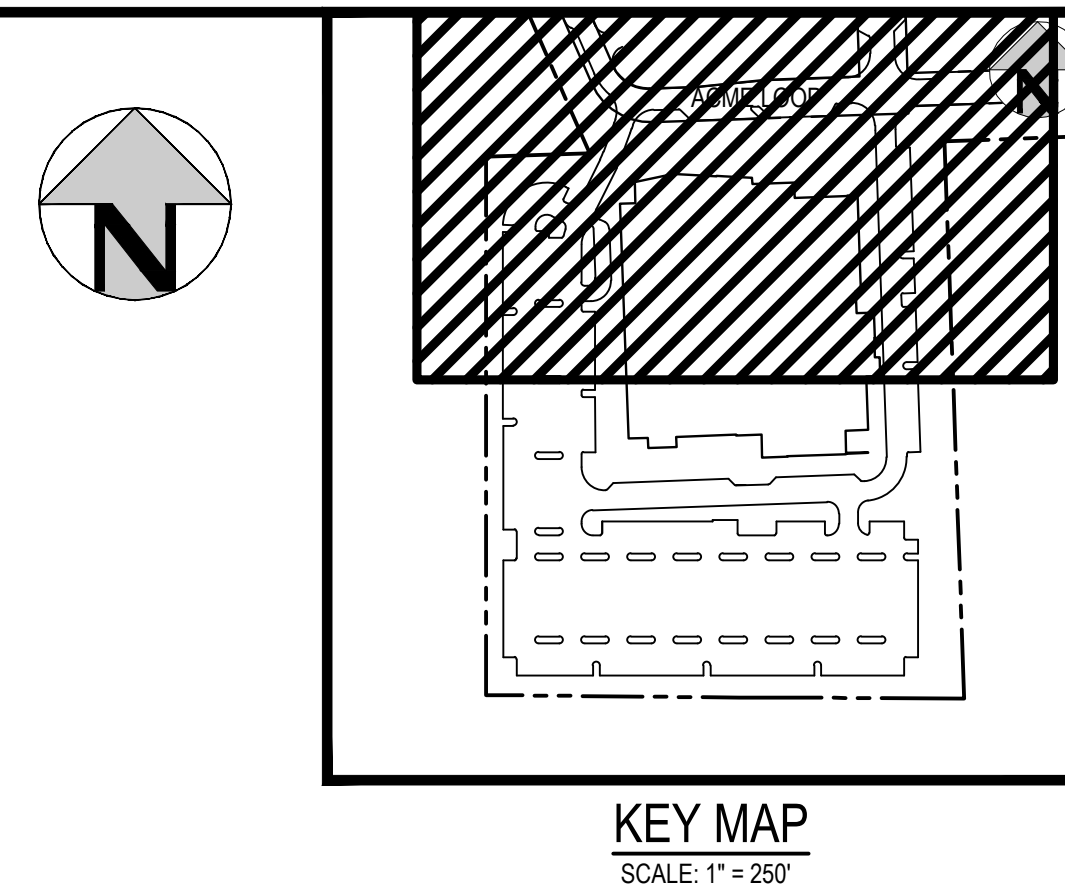

- # GENERAL LANDSCAPE DRAIN NOTES:
1. CONTRACTOR SHALL USE 90-DEGREE WYES AT PERPENDICULAR JOINTS WHERE POSSIBLE.
 2. CONTRACTOR SHALL USE CONCENTRIC REDUCERS UNLESS OTHERWISE NOTED. WHERE ECCENTRIC REDUCERS ARE USED THE INVERTS MUST MATCH.
 3. CONTRACTOR SHALL USE STANDARD PVC FITTINGS WHEN POSSIBLE. UNLESS OTHERWISE NOTED ON THE PLAN.
 4. ALL LANDSCAPE DRAIN PIPES SHALL BE WATERTIGHT PVC, RIGID HDPE WITH SMOOTH INNER WALL, OR ENGINEER APPROVED EQUIVALENT.
 5. ALL LANDSCAPE DRAIN PIPES SHALL BE A MINIMUM OF 2-FIT DEEP (UNLESS OTHERWISE NOTED) AND SHALL HAVE A 0.50% MINIMUM SLOPE.
 6. LANDSCAPE DRAINS IN LANDSCAPED AREAS SHALL BE NYLOPLAST 12-INCH DOME STYLE GRATES/COVERS, OR ENGINEER-APPROVED EQUIVALENT.
 7. LANDSCAPE DRAIN GRATES IN PAVEMENT SHALL BE PEDESTRIAN-FRIENDLY, 4-INCH ROUND BRASS GRATES OR ENGINEER-APPROVED EQUIVALENT UNLESS OTHERWISE NOTED ON THE PLAN.
 8. TRENCH DRAINS SHALL BE ACO KLASIK KS100S WITH TYPE 461Q DUCTILE IRON SLOTTED GRATE OR ENGINEER-APPROVED EQUIVALENT. TRENCH DRAINS SHALL HAVE AN INVERT SLOPE OF AT LEAST 0.50%. TRENCH DRAIN INVERT SHALL MATCH THE CONNECTING LANDSCAPE DRAIN PIPE INVERT. FOR GRADE ELEVATIONS SEE SHEET(S) C08 - C018.
 9. LANDSCAPE DRAINS CALLED AT THE END OF A LINE SHALL BE INSTALLED WITH A RISER AND 90 DEGREE BEND MATCHING THE SIZE OF THE PIPE CONNECTING TO THE DRAIN AS CALLED OUT IN THE LANDSCAPE DRAIN TABLE.
 10. LANDSCAPE DRAINS CONNECTING TO ROOF DOWNSPOUTS SHALL BE INSTALLED WITH A RISER AND 90 DEGREE BEND MATCHING THE SIZE OF THE PIPE CONNECTING TO THE ROOF DRAIN AS CALLED OUT IN THE LANDSCAPE DRAIN TABLE.
 11. INLINE LANDSCAPE DRAINS SHALL BE INSTALLED WITH A RISER AND TIE FITTING MATCHING THE SIZE OF THE MAIN LINE CONNECTION AS CALLED OUT IN THE LANDSCAPE DRAIN TABLE. IF TWO OR MORE PIPES CROSS INTERSECT AT THE INLINE DRAIN CONNECTION THEN THE LARGER PIPE SIZE SHALL DICTATE THE SIZE OF THE RISER.
 12. AT ANY LOCATION WHERE MORE THAN TWO LANDSCAPE DRAIN PIPE INTERSECT AND CANNOT BE CONNECTED WITH STANDARD FITTINGS, A DRAIN BASIN SHALL BE INSTALLED. THE DRAIN BASIN SHALL BE SIZED ACCORDING TO THE MANUFACTURER'S SPECIFICATIONS.
 13. FOR GRADE 12/ELEVATIONS SEE DETAILED GRADING PLAN SHEET(S).

PROFESSIONAL ENGINEER CERTIFICATION

I HEREBY AFFIRM THAT THESE FINAL CONSTRUCTION PLANS WERE PREPARED UNDER MY DIRECT SUPERVISION, IN ACCORDANCE WITH ALL APPLICABLE TOWN OF CASTLE ROCK AND STATE OF COLORADO STANDARDS AND STATUTES, RESPECTIVELY; AND THAT I AM FULLY RESPONSIBLE FOR ALL DESIGN AND REVISIONS RELATIVE TO SAID PLANS.

JOHN D O'ROURKE, P.E. #43327

TOWN OF CASTLE ROCK APPROVAL
PLANS ARE HEREBY APPROVED FOR ONE YEAR FROM DATE OF
DEVELOPMENT SERVICES APPROVAL

Approved By:

Development Services

PROJECT #: 200726

SHEET NUMBER

CD25

25 OF 39

PIPE TABLE						
NAME	SIZE	LENGTH	SLOPE	MATERIAL	UPSTREAM INVERT	DOWNSTREAM INVERT
A-1	8"	22.15'	13.00%	PVC	6250.05	6247.17
A-2	8"	39.62'	1.50%	PVC	6250.65	6250.05
A-3	8"	12.56'	1.50%	PVC	6250.84	6250.65
A-4	8"	31.04'	1.50%	PVC	6251.30	6250.84
A-5	6"	49.78'	1.50%	PVC	6251.67	6250.92
A-6	6"	11.21'	1.50%	PVC	6251.84	6251.67
A-7	6"	10.02'	18.26%	PVC	6253.67	6251.84
A-8	6"	5.04'	1.50%	PVC	6251.92	6251.84
A-9	6"	30.34'	1.50%	PVC	6252.13	6251.67


PIPE TABLE						
NAME	SIZE	LENGTH	SLOPE	MATERIAL	UPSTREAM INVERT	DOWNSTREAM INVERT
A-10	6"	4.95'	1.50%	PVC	6252.20	6252.13
A-11	6"	15.61'	1.50%	PVC	6252.43	6252.20
B-1	8"	5.00'	2.00%	PVC	6244.37	6244.27
B-2	8"	4.79'	2.00%	PVC	6244.47	6244.37
B-3	8"	60.28'	5.45%	PVC	6247.76	6244.47
B-4	8"	22.26'	23.54%	PVC	6253.00	6247.76
C-1	6"	43.45'	7.82%	PVC	6249.42	6246.02
C-2	6"	20.03'	7.82%	PVC	6250.99	6249.42
C-3	6"	34.29'	7.82%	PVC	6253.67	6250.99

PIPE TABLE						
NAME	SIZE	LENGTH	SLOPE	MATERIAL	UPSTREAM INVERT	DOWNSTREAM INVERT
D-1	8"	16.64'	12.38%	PVC	6258.16	6256.10
D-2	8"	24.89'	12.40%	PVC	6261.25	6258.16
E-1	6"	28.30'	2.72%	PVC	6261.57	6260.80
E-2	6"	26.37'	2.72%	PVC	6262.29	6261.57
E-3	6"	22.33'	2.72%	PVC	6262.90	6262.29
E-4	6"	10.00'	2.70%	PVC	6263.17	6262.90
E-5	6"	19.16'	1.50%	PVC	6263.19	6262.90
LD-1	4"	14.13'	2.00%	PVC	6245.36	6245.08
LD-2	4"	7.20'	101.39%	PVC	6252.66	6245.36

PIPE TABLE						
NAME	SIZE	LENGTH	SLOPE	MATERIAL	UPSTREAM INVERT	DOWNSTREAM INVERT
LD-3	4"	5.37'	0.56%	PVC	6252.69	6252.66
LD-4	4"	24.15'	1.16%	PVC	6252.97	6252.69
LD-5	4"	56.38'	1.12%	PVC	6253.29	6252.66
LD-6	4"	28.18'	3.55%	PVC	6254.29	6253.29
LD-7	4"	12.33'	2.51%	PVC	6254.60	6254.29



Know what's below.
Call before you dig.

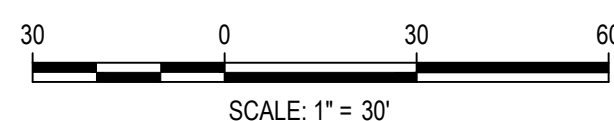

DESIGNED BY: AS
CHECKED BY: JDO
DRAWN BY: AS

ISSUE DATE: 05-24-2024

DATE	REVISION COMMENTS
06-04-2024	30% CD
07-31-2024	50% CD
08-30-2024	70% CD
10-02-2024	95% CD
10-22-2024	PRICING SET
11-08-2024	TOWN SUBMITTAL



1120 Lincoln Street, Suite 1000
Denver, Colorado 80203
P: 303.623.6300 F: 303.623.6311
HarrisKocherSmith.com

CONFLUENCE COMPANIES, LLC

CASTLE ROCK SPORT CENTER

LANDSCAPE DRAIN PLAN

PROJECT #:	200726
------------	--------

SHEET NUMBER

CD25

25 OF 39

10/7/2023 9:45:59 AM Autodesk Docs/Castle Rock Sports Center CRSC - Architecture_2024.rvt



1 PLANTING PLAN
SCALE: 1" = 20'-0"

LANDSCAPE KEYNOTES

- 0.0 EXISTING CONDITIONS**
- 1.0 PAVING**
- 1.1 CIP CONCRETE PAVING, SAWS JTS
A | TYPE 1
COLOR: GRAY
FINISH: MEDIUM BROOM
B | TYPE 2
COLOR: INTEGRAL (TBD)
FINISH: SAND / SANDSCAPE
- 1.4 ARTIFICIAL TURF
MANUFACTURER: SYNLAWN
A | TYPE 1: PLAY PLATINUM W/ SAFETY PAD
B | TYPE 2: SYNLAUGUSTINE 347
DECOMPOSED GRANITE (STABILIZED)
- 2.0 PAVEMENT JOINING
- 2.1 EXPANSION JOINT
2.2 SAWN CONTROL JOINT
- 3.0 CURBS, EDGES, STEPS**
- 3.1 EDGER
B | ARTIFICIAL TURF ADJ. PLANTING STEEL RESTRAINT
C | PLANTING AREA STEEL EDGING RESTRAINT
CIP CONC. STEPS W/ SS HANDRAIL
COLOR: TBD
FINISH: MED. BROOM
A | 6 RISERS
B | 7 RISERS
C | 5 RISERS
- 4.0 WALLS**
- 4.2 MSE RETAINING WALL
- 5.0 SITE FURNISHINGS AND ELEMENTS**
- 5.1 CO BUFF SANDSTONE BOULDER
SIZES VARY, RE PLANS
B | SLAB SEATING (DRAINAGE VARIES)
D | TERRACE BOULDER SEATING FEATURE
E | LANDSCAPE BOULDER
F | TERRACE BOULDER SEATING FEATURE
BIKE RACK (OWNER FURNISHED)
5.2 TRASH RECEPTACLE (OWNER FURNISHED)
5.3 STONE SEATING SLAB (2' x 2' x LENGTH PER PLANS)
5.12 FENCING - PLAY AREA
- 6.0 SITE LIGHTING**
- 6.1 POLE MOUNTED OVERHEAD LIGHTS
A | STREET
B | PARKING LOT
PEDESTRIAN LIGHT
- 7.0 PLANTING**
- 7.1 TREES
A | DECIDUOUS TREE
B | EVERGREEN TREE
C | ORNAMENTAL TREE
7.2 MULCH
A | WOOD
B | COBBLE
7.3 NATIVE SEED
- DTL 12 / SHT L400
DTL 14 / SHT L400
DTL 11 / SHT L400
DTL 15 / SHT L400
DTL 15 / SHT L400
DTL 6 / SHT L400
DTL 2 / SHT L400
DTL 1 / SHT L400
DTL 2A / SHT L400
DTL 17 / SHT L400
DTL 5 / SHT L400
DTL 8 / SHT L400
DTL 9 / SHT L400
SHT L401
DTL 3 / SHT L400
DTL 4 / SHT L400
DTL 1 & 2 / SHT L402
DTL 1 & 2 / SHT L402
DTL 1 & 2 / SHT L402
DTL 7 / SHT L402
DTL 6 / SHT L402
SPEC SECTION 32 9200

MATERIALS LEGEND

- 7.3 NATIVE SEED

UTILITY LEGEND

- SS — SANITARY SEWER LINE
W — WATER LINE
ST — STORM SEWER LINE

ELECTRICAL LINE

- E — GAS LINE
G —

NOTE:
REFERENCE CIVIL ENGINEERS
DRAWINGS FOR ALL UTILITY
INFORMATION AND SYMBOLS.

PLANT SCHEDULE

RE SHEET L200B FOR PLANT SCHEDULE

LANDSCAPE DOES NOT MEET CORE CLEARANCES

Comment
addressed. Plan was
revised.

