



.:PROJECT.:

◆ 607 Sixth Street Castle Rock CO 80104 Douglas County ◆ #Site Name ◆

.. SHEET DESCRIPTION ::

MAIN LEVEL PLAN

2026.06.10

∴ SHEET NUMBER :

DR1.1



PEACH ADDITION & DETACHED GARAGE
♦ 607 Sixth Street Castle Rock CO 80104 Douglas County ♦ #Site Name ♦

UPPER LEVEL PLAN

◆ AS-BUILT ◆

◆ GENERAL CONTRACTOR ◆

.: SHEET NUMBER :.

DR1.2


$$\underline{1/4'' = 1'-0''}$$

$$\underline{1/4'' = 1'-0''}$$



.: SHEET DESCRIPTION:.


 
2D ELEVATIONS

.. SHEET NUMBER:..

DR2.0

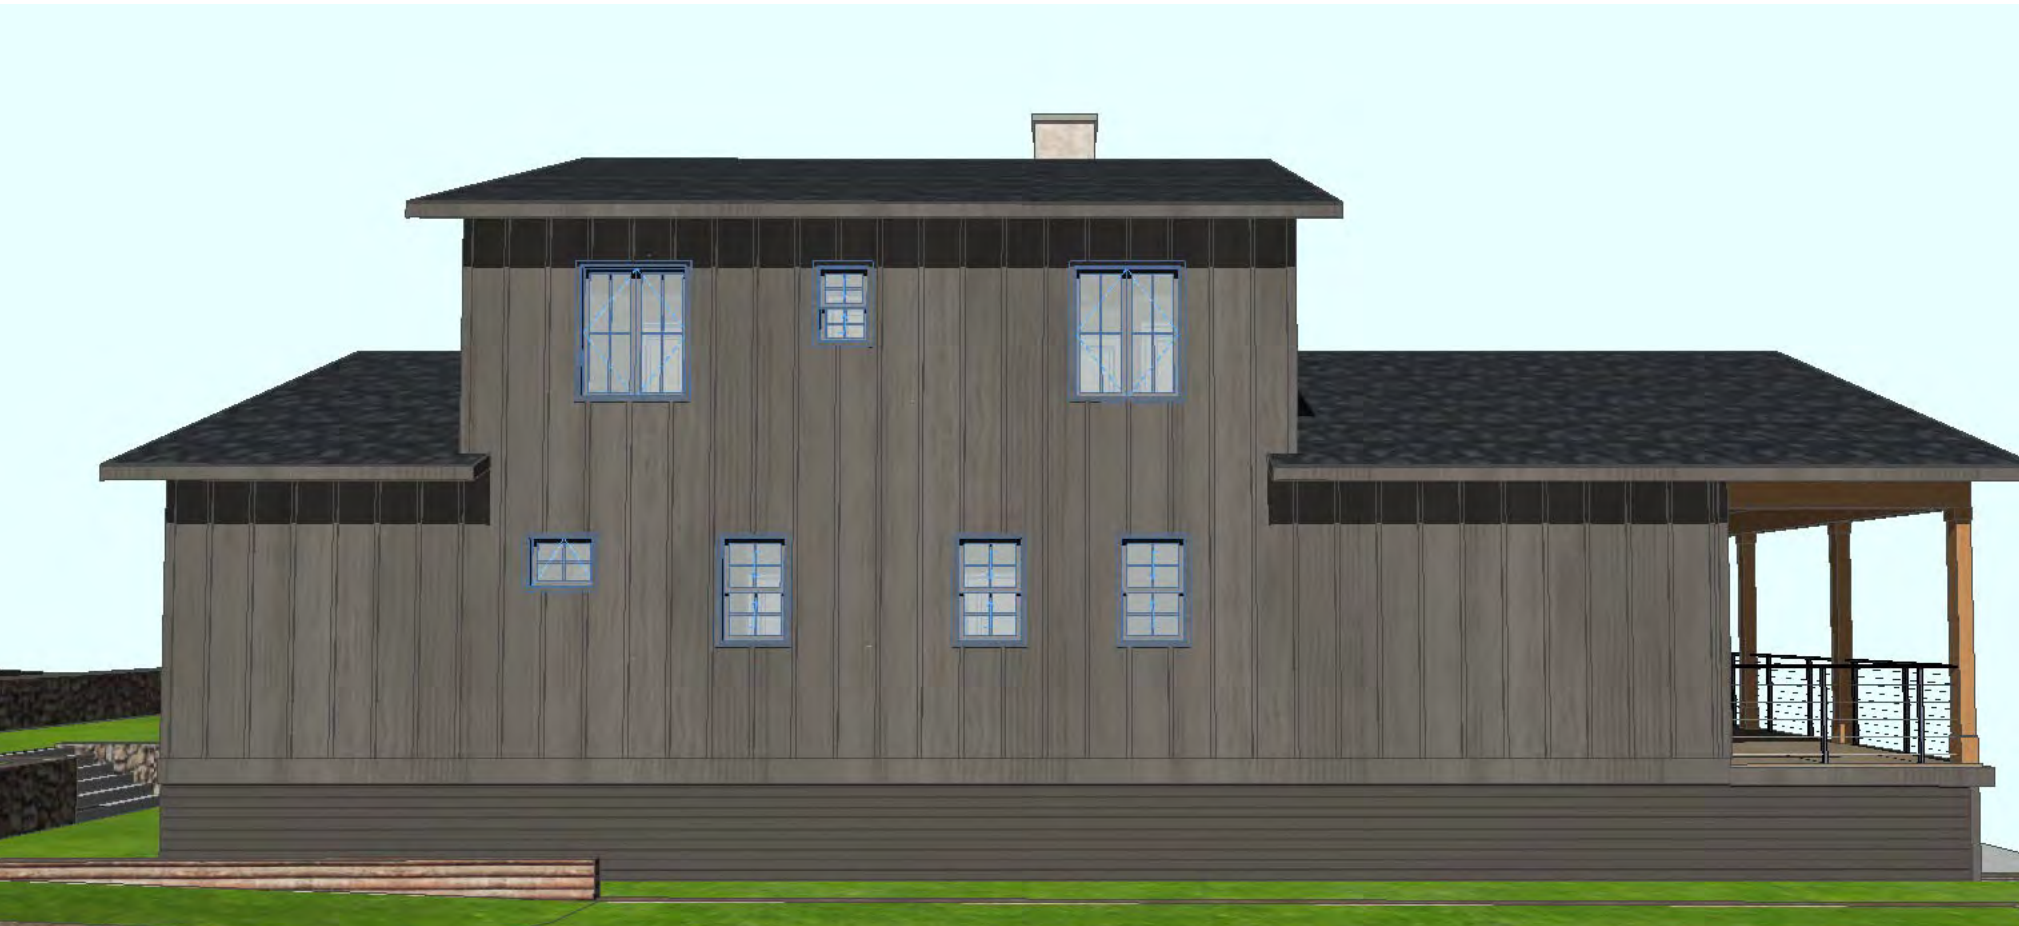


$$1/4'' = 1'-0''$$
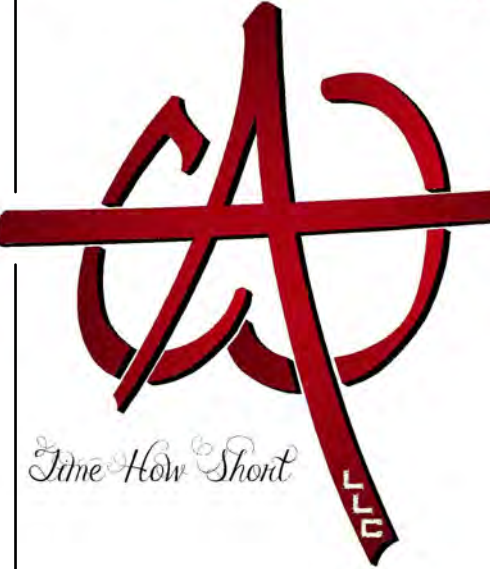
$$1/4'' = 1'-0''$$


◆ AS-BUILT ◆


--	--

..: SHEET DESCRIPTION ::


..: SHEET DESCRIPTION ::

2D ELEVATIONS

.: SHEET NUMBER :.

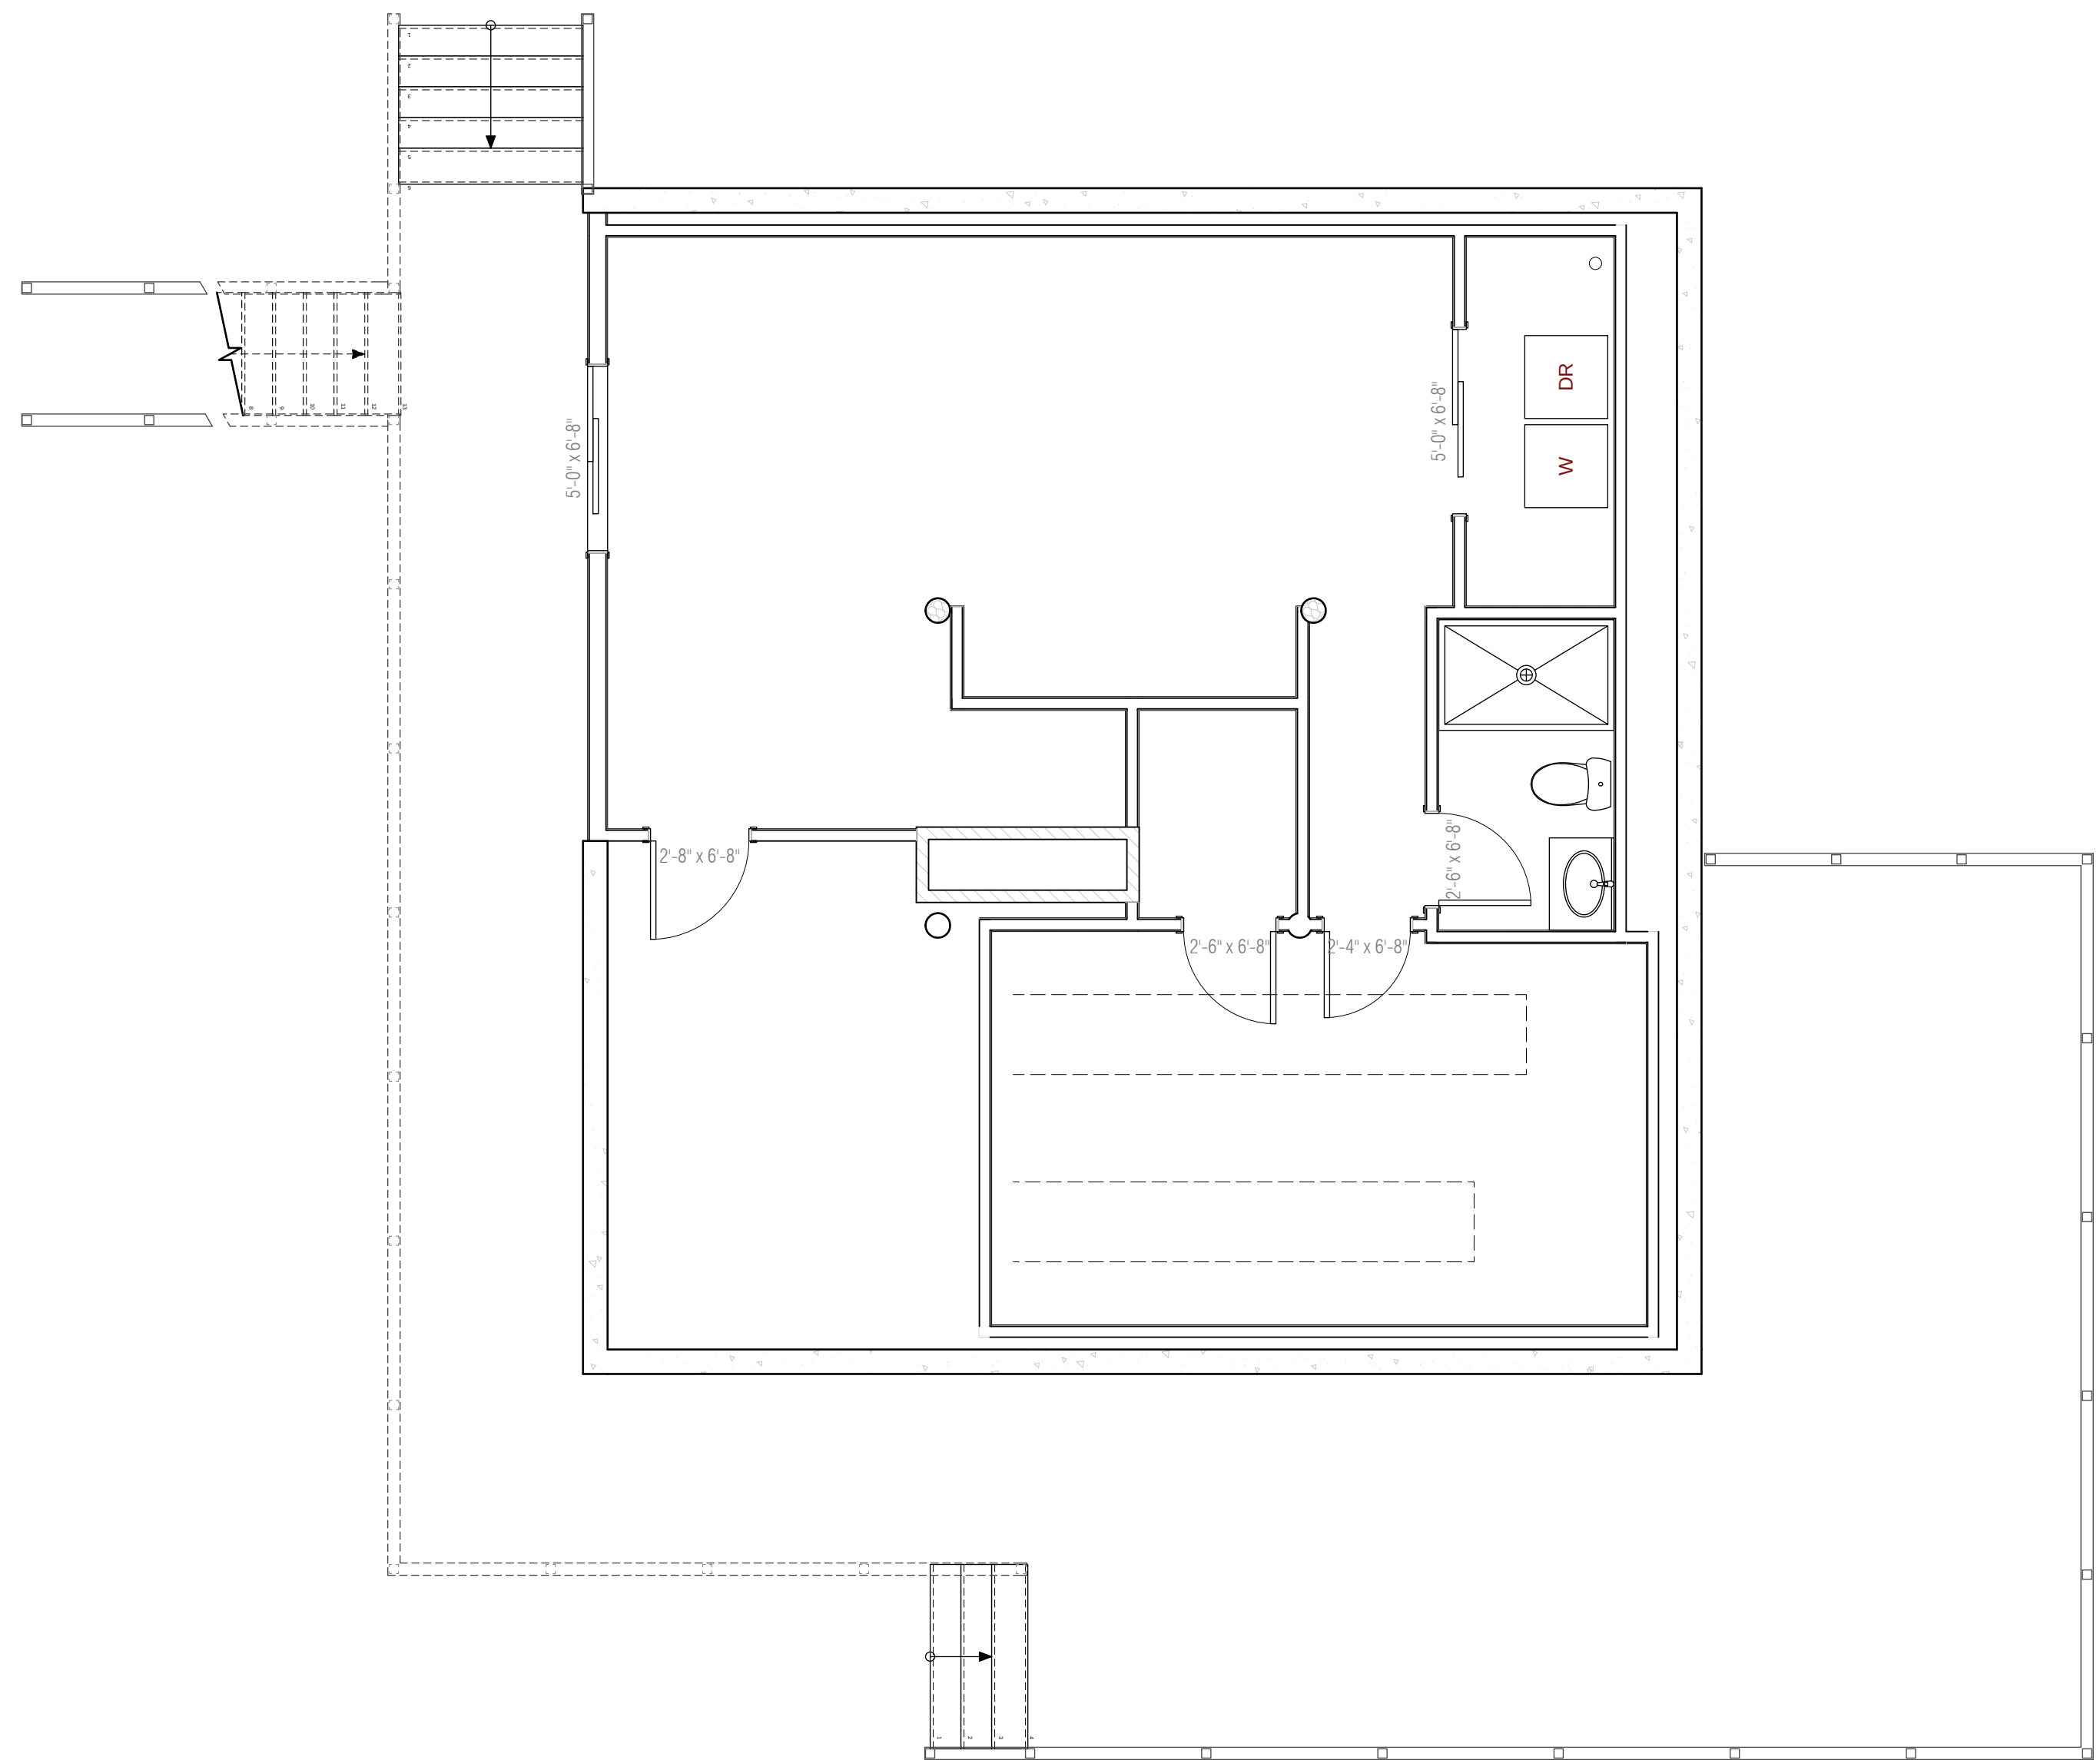

BASEMENT, WALK-OUT: AS-BUILT PLAN

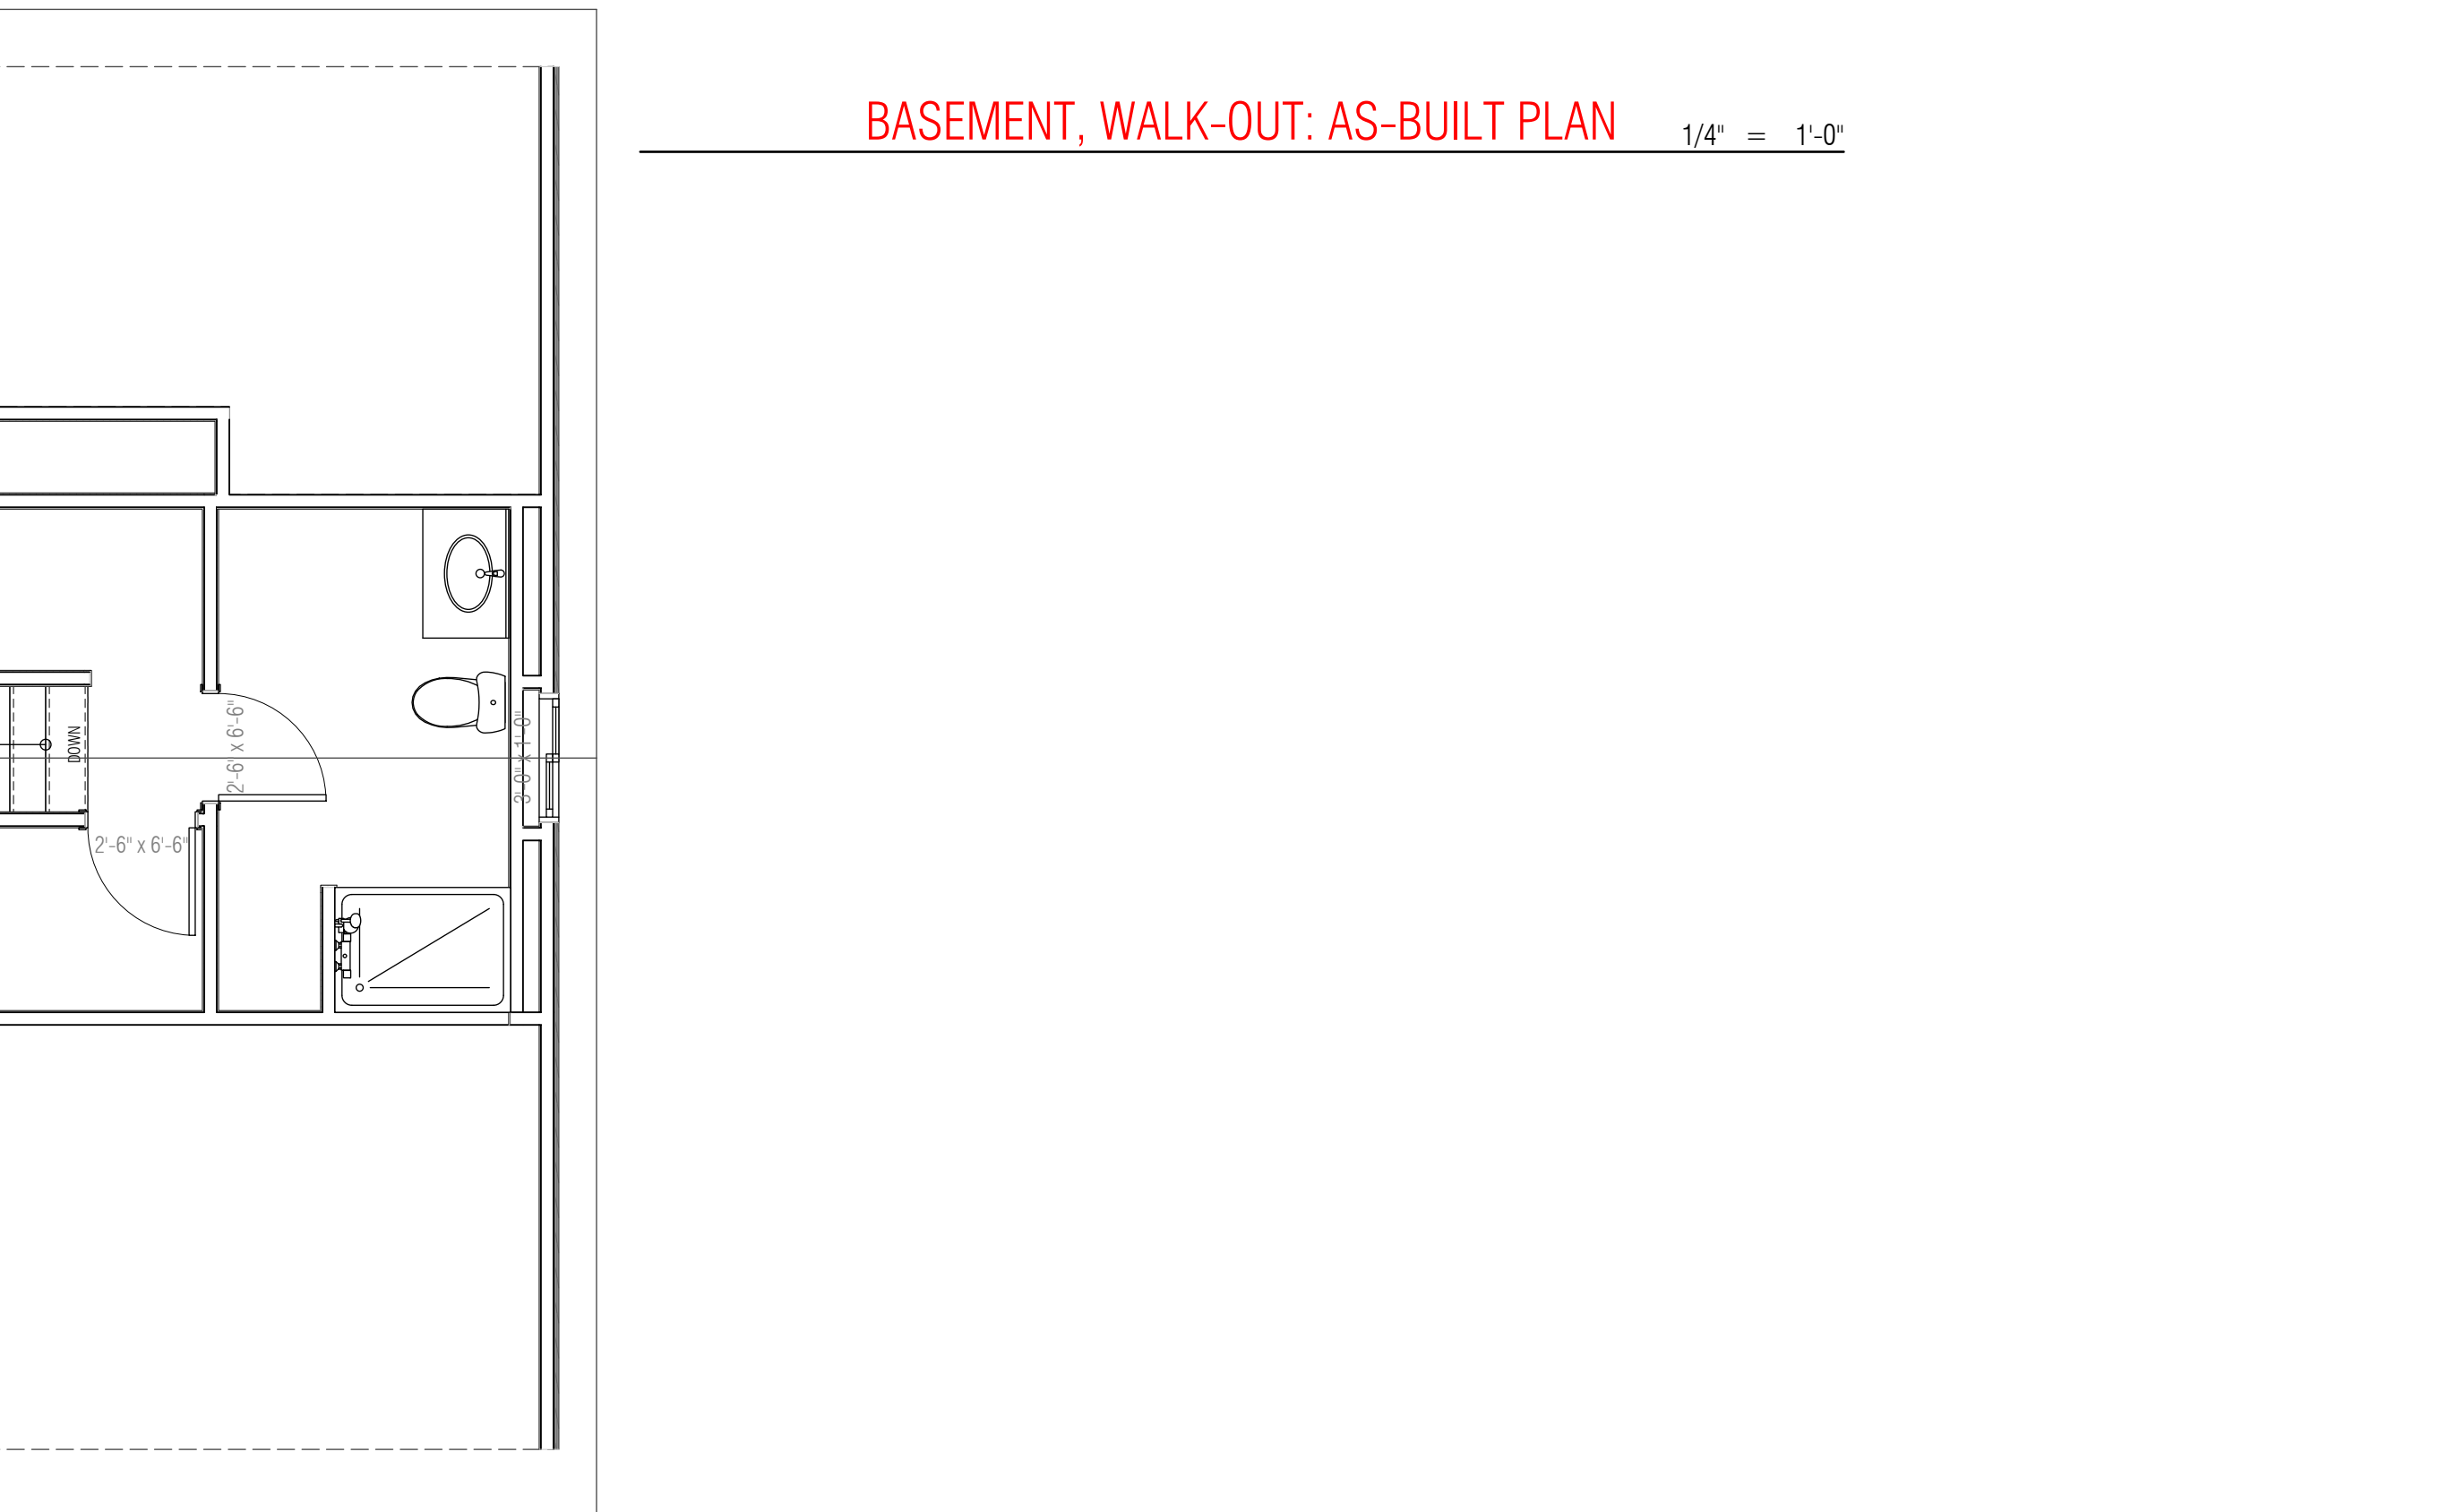

AKINS CADD WORKS LLC

True Hon Short

106 Birch Avenue
 Castle Rock, CO 80104
 phone: 909-921-3537
 email: Robert@ACW.red

PROJECT :
PEACH ADDITION & DETACHED GARAGE
 ♦ 607 Sixth Street Castle Rock CO 80104 Douglas County ♦ #Site Name ♦
 SHEET DESCRIPTION :
FLOOR PLANS: AS-BUILT

..: SHEET DESCRIPTION :..

FLOOR PLANS: AS-BUILT

2026.06.10

.. SHEET NUMBER ..

AB1.0



PEACH ADDITION & DETACHED GARAGE
 ♦ 607 Sixth Street Castle Rock CO 80104 Douglas County ♦ #Site Name ♦
 : PROJECT :

: SHEET DESCRIPTION ::

LOWER LEVEL PLAN

2026.06.10

.: SHEET NUMBER :.

DR1.0