

HH SUBDIVISION - SECOND AMENDMENT
LOT 1, H H SUBDIVISION - SECOND AMENDMENT
IN SECTION 2, TOWNSHIP 8 SOUTH, RANGE 67 WEST, 6th P.M.,
TOWN OF CASTLE ROCK, COUNTY OF DOUGLAS, STATE OF COLORADO

OWNERS:
1. DC Ward LLC
524 S Tejon St,
Colorado Springs, CO 80903

1. Maintenance responsibility lies with the owner of the land, except as modified by specific agreement. The property owner or designee shall be responsible for the maintenance of all drainage facilities including inlets, pipes, culverts, channels, ditches, hydraulic structures, and detention basins located on their land unless modified by specific agreement.

SHOULD THE OWNER FAIL TO ADEQUATELY MAINTAIN SAID FACILITIES, THE TOWN SHALL HAVE THE RIGHT TO ENTER SAID PROPERTY FOR THE PURPOSES OF OPERATING AND MAINTAINING THE SAME. ALL SUCH MAINTENANCE COSTS SHALL BE ASSESSED TO THE PROPERTY OWNER.

MAINTENANCE COSTS SHALL INCLUDE ALL COSTS FOR LABOR, EQUIPMENT AND MATERIALS, AND SHALL BE CHARGED AT 1.25 TIMES THE ACTUAL COST.

3. Bearings are plotted and based on the consideration that the West Line of Lot 1, HH Subdivision - First Amendment Recorded under Rec No 9632856, County of Douglas, State of Colorado N00°33'00"E; Southwesterly corner is #5 Rebar 18" Long with a 1-1/4" diameter red plastic cap stamped PLS 6935; Northwesterly corner is cross chisled in concrete as shown hereon between the identified monuments.

4. There are no mapped FEMA floodplains on this parcel, per FIRM panel 08035C0188G, effective March 16, 2016.

The purpose of this replat is to create two Lots from one existing lot for future Parking.

LOT 1, H H SUBDIVISION - SECOND AMENDMENT
TOWN OF CASTLE ROCK, DOUGLAS COUNTY, CO.

CONTAINING 1.97 ACRES MORE OR LESS.


The undersigned, being all of the owners, mortgagees and lienholders of certain lands in the Town of Castle Rock, County of Douglas and State of Colorado described herein, have laid out, platted 2 lots from one single lot, as shown on this plat under the name and style of HH Subdivision – Second Amendment. The undersigned hereby dedicates to the Town of Castle Rock for the purposes of ownership of all public access and drainage easements as described and shown hereon.

Signed this _____ day of _____, 20_____

Subscribed and sworn to before me this _____ day of _____,
20_____ by _____.


My commission expires: _____

Notary Public

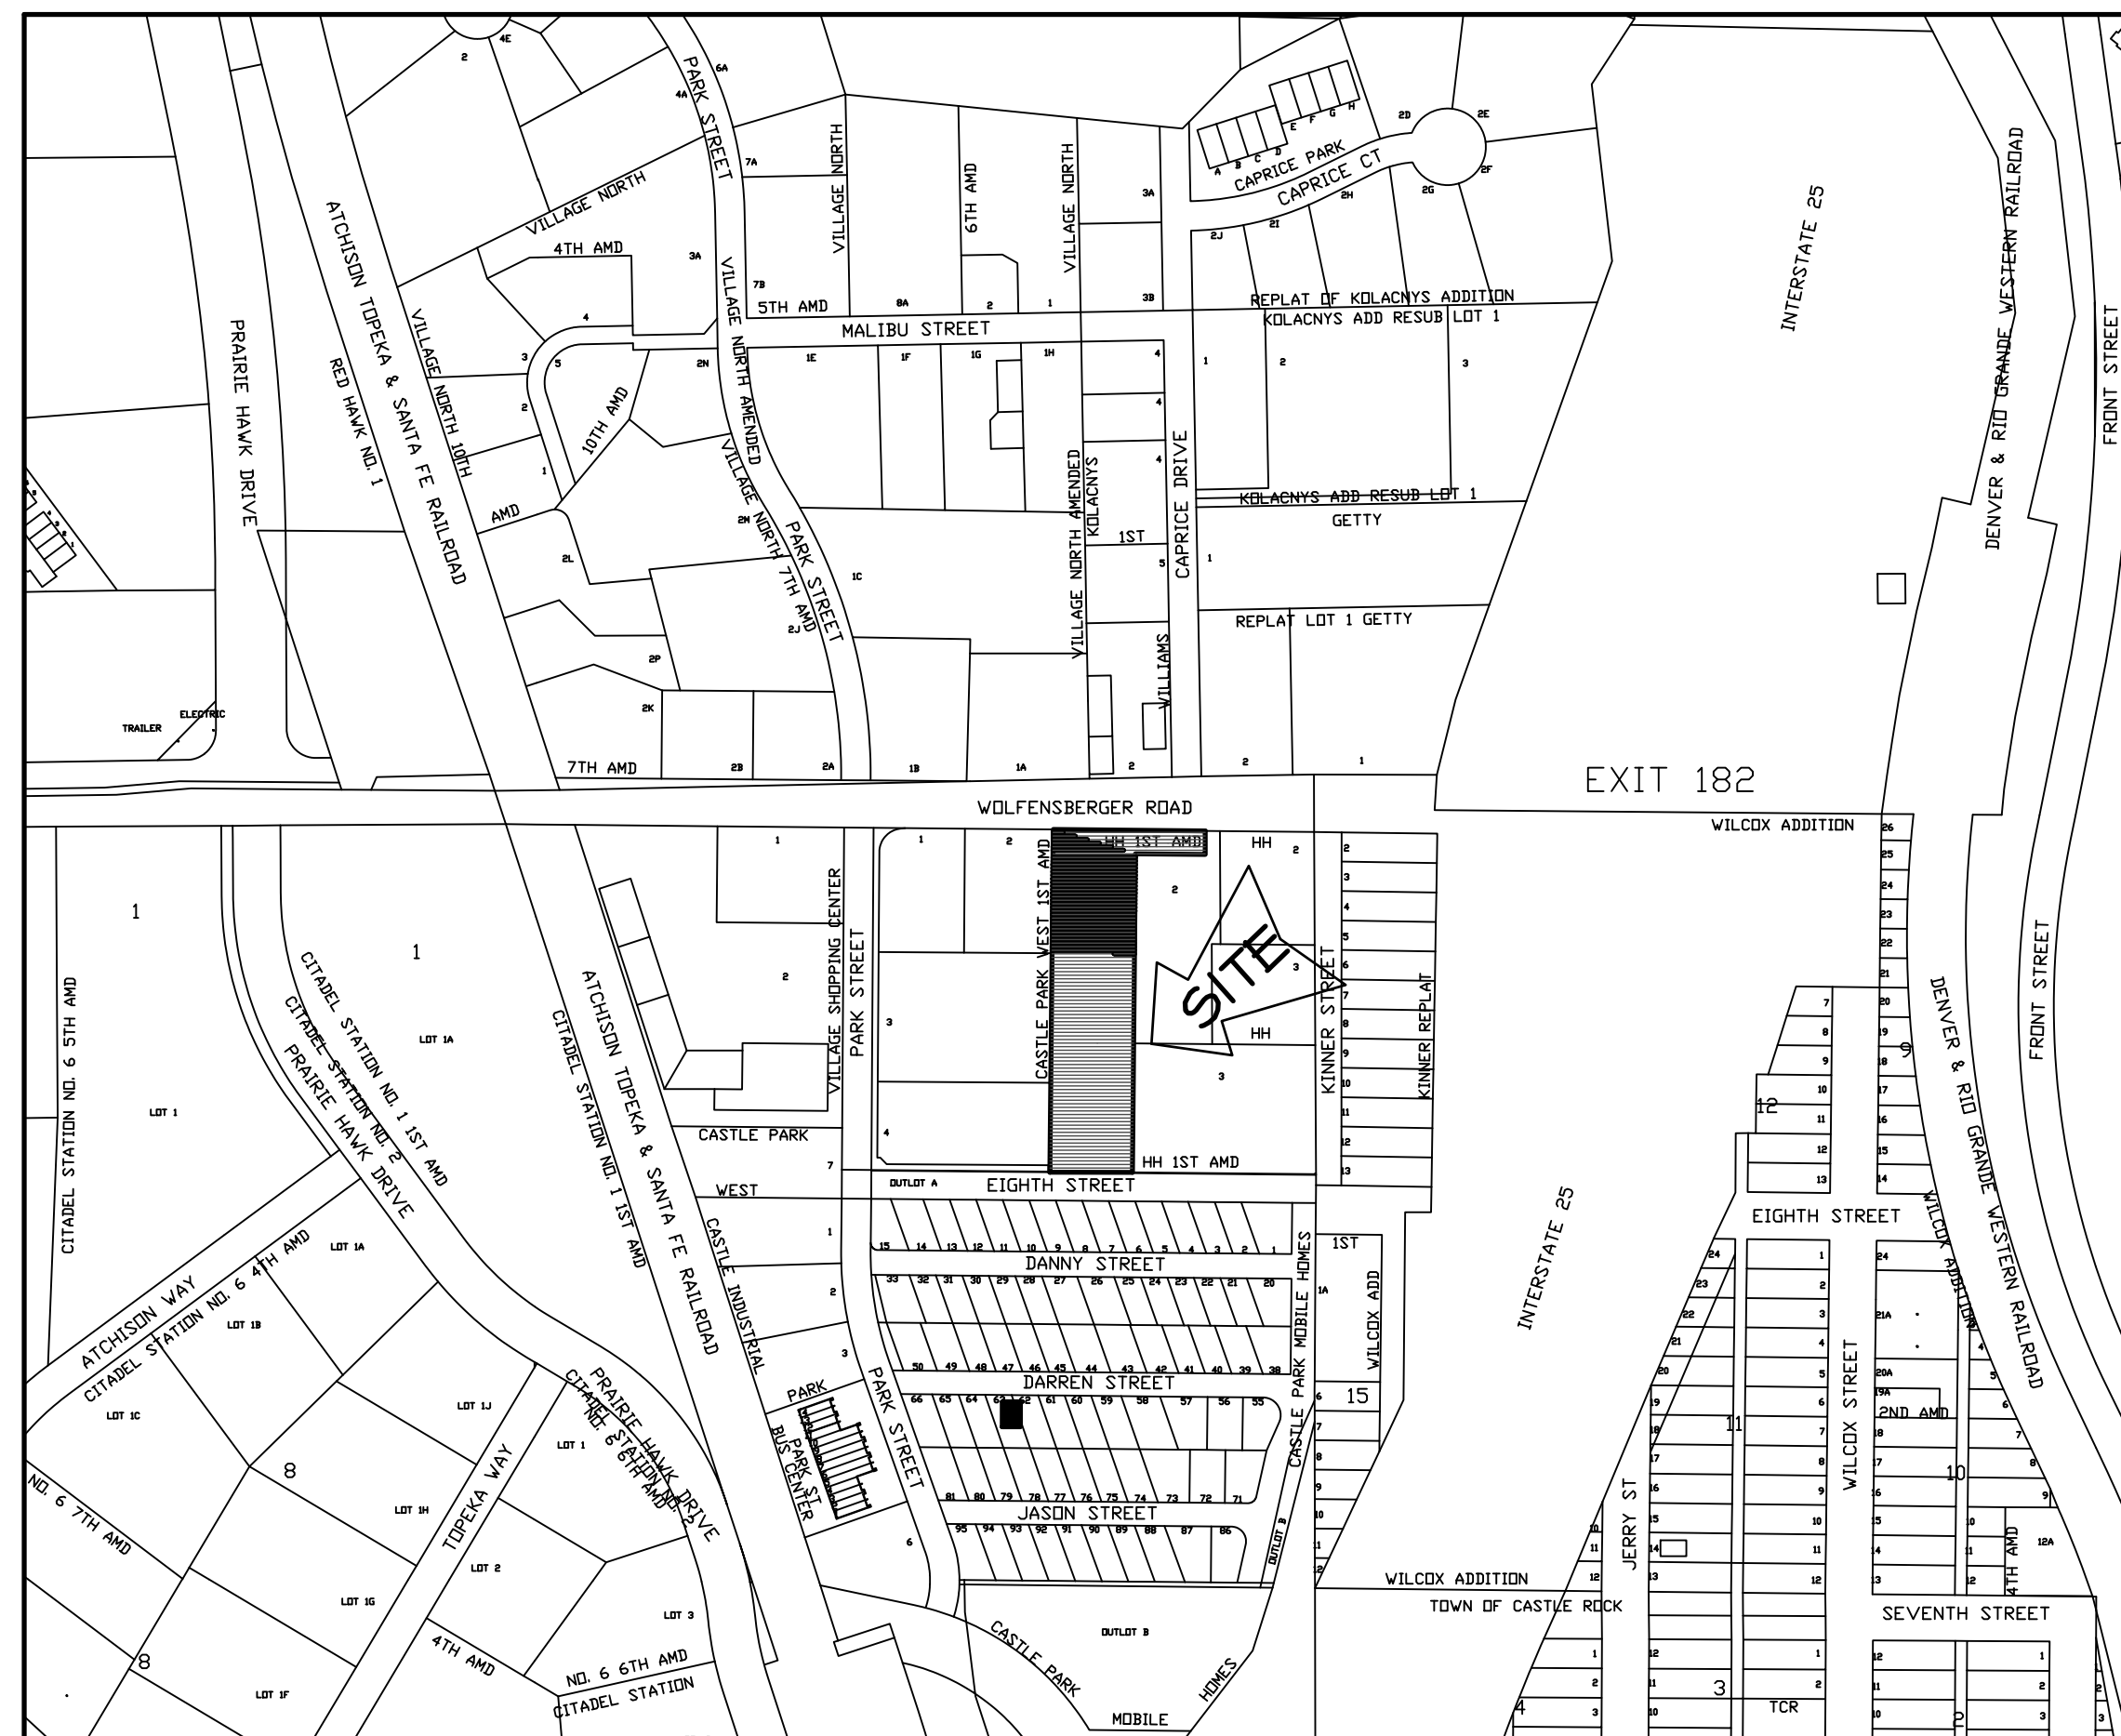

VICINITY MAP

1"=300

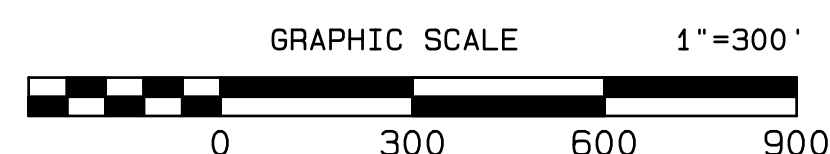

The town of Castle Rock has acquired control of the Water Rights through the adoption of Ordinance No. 97-17 and pursuant to the implied consent provision of C.R.S. 37-90-137(8).

SUMMARY TABLE	(ACRES)	(PERCENT)
LOT 1A	1.64 AC.	83.2%
LOT 2A	0.33 AC.	16.8%
TOTAL	1.97 AC.	100.0%

SHEET INDEX

SHEET 1 OF 2
SHEET 2 OF 2

COVER SHEET
PLAT

"NOTICE: According to Colorado law you must commence any legal action based upon any defect in this survey within three years after you first discover such defect. In no event, may any action based upon any defect in this survey be commenced more than ten years from the date of the certification shown hereon."

REVISIONS 	 DAVID E. ARCHER & ASSOCIATES, INC. LAND DEVELOPMENT CONSULTING SURVEYING & ENGINEERING PHONE (303) 688-4642 105 WILCOX ST., CASTLE ROCK, COLORADO 80104		SCALE _____ N/A DATE 12-02-22 D.R.N. _____ R.K.D. _____ A.P.V.D. _____	TITLE HH SUBDIVISION-SECOND AMENDMENT IN SECTION 2, TOWNSHIP 8 SOUTH, RANGE 6T WEST, 6th P.M., TOWN OF CASTLE ROCK, COUNTY OF DOUGLAS, STATE OF COLORADO. CLIENT CASTLE OAKS CHURCH	JOB NUMBER Sheet 1 of 2 21-1548
---	---	---	---	--	---

I, _____, an authorized representative of First American Title Insurance Company, a Title Insurance Company licensed to do business in the State of Colorado, have made an examination of the public records and state that all owners, mortgagees and lienholders of the property are listed in the Certificate of Ownership and lienholder subordination certificate.

First American Title Insurance Company

Signed this _____ day of _____, 20_____.

Subscribed and sworn to before me this _____ day of _____,
20_____ by _____.

My commission expires: _____.

Notary Public

This amended plat was approved by the Director of Development Services of the Town of Castle Rock, Colorado on the _____ day of _____, 20____.

Director of Development Services

On behalf of the Town Council of the Town of Castle Rock, Colorado, I hereby certify that this amended plat was approved in accordance with all applicable regulations and the the dedications on this plat are hereby accepted by the Town of Castle Rock.

Date _____

Attest:

Date _____

I, Johnny Calvin Hicks, a registered professional land surveyor in the state of Colorado, do hereby certify that the survey and legal description represented by this amended plat was made under my supervision and the monuments shown thereon actually exist and this amended plat accurately represents that survey.

Date _____

STATE OF COLORADO
COUNTY OF DOUGLAS

I hereby certify that this amended plat was filed in my office on this _____ day of _____, 20____ A.D., at _____ a.m./p.m., and was recorded at Reception Number _____.


Douglas County Clerk and Recorder

PROJECT NO. PL22-

TITLE	
HH SUBDIVISION-SECOND AMENDMENT	
N/A	IN SECTION 2, TOWNSHIP 8 SOUTH, RANGE 67
2	WEST, 6TH P.M., TOWN OF CASTLE ROCK, COUNTY
	OF DOUGLAS, STATE OF COLORADO.
CLIENT	
CASTLE OAKS CHURCH	
JOB NUMBER	
Sheet 1 of 2	21-1548

S:\Drawings\2021\21-1548\REPLAT\REPLAT.pro
Fri Dec 02 13:34:14 2022


HH SUBDIVISION - SECOND AMENDMENT
LOT 1, H H SUBDIVISION - SECOND AMENDMENT
IN SECTION 2, TOWNSHIP 8 SOUTH, RANGE 67 WEST, 6th P.M.,
TOWN OF CASTLE ROCK, COUNTY OF DOUGLAS, STATE OF COLORADO

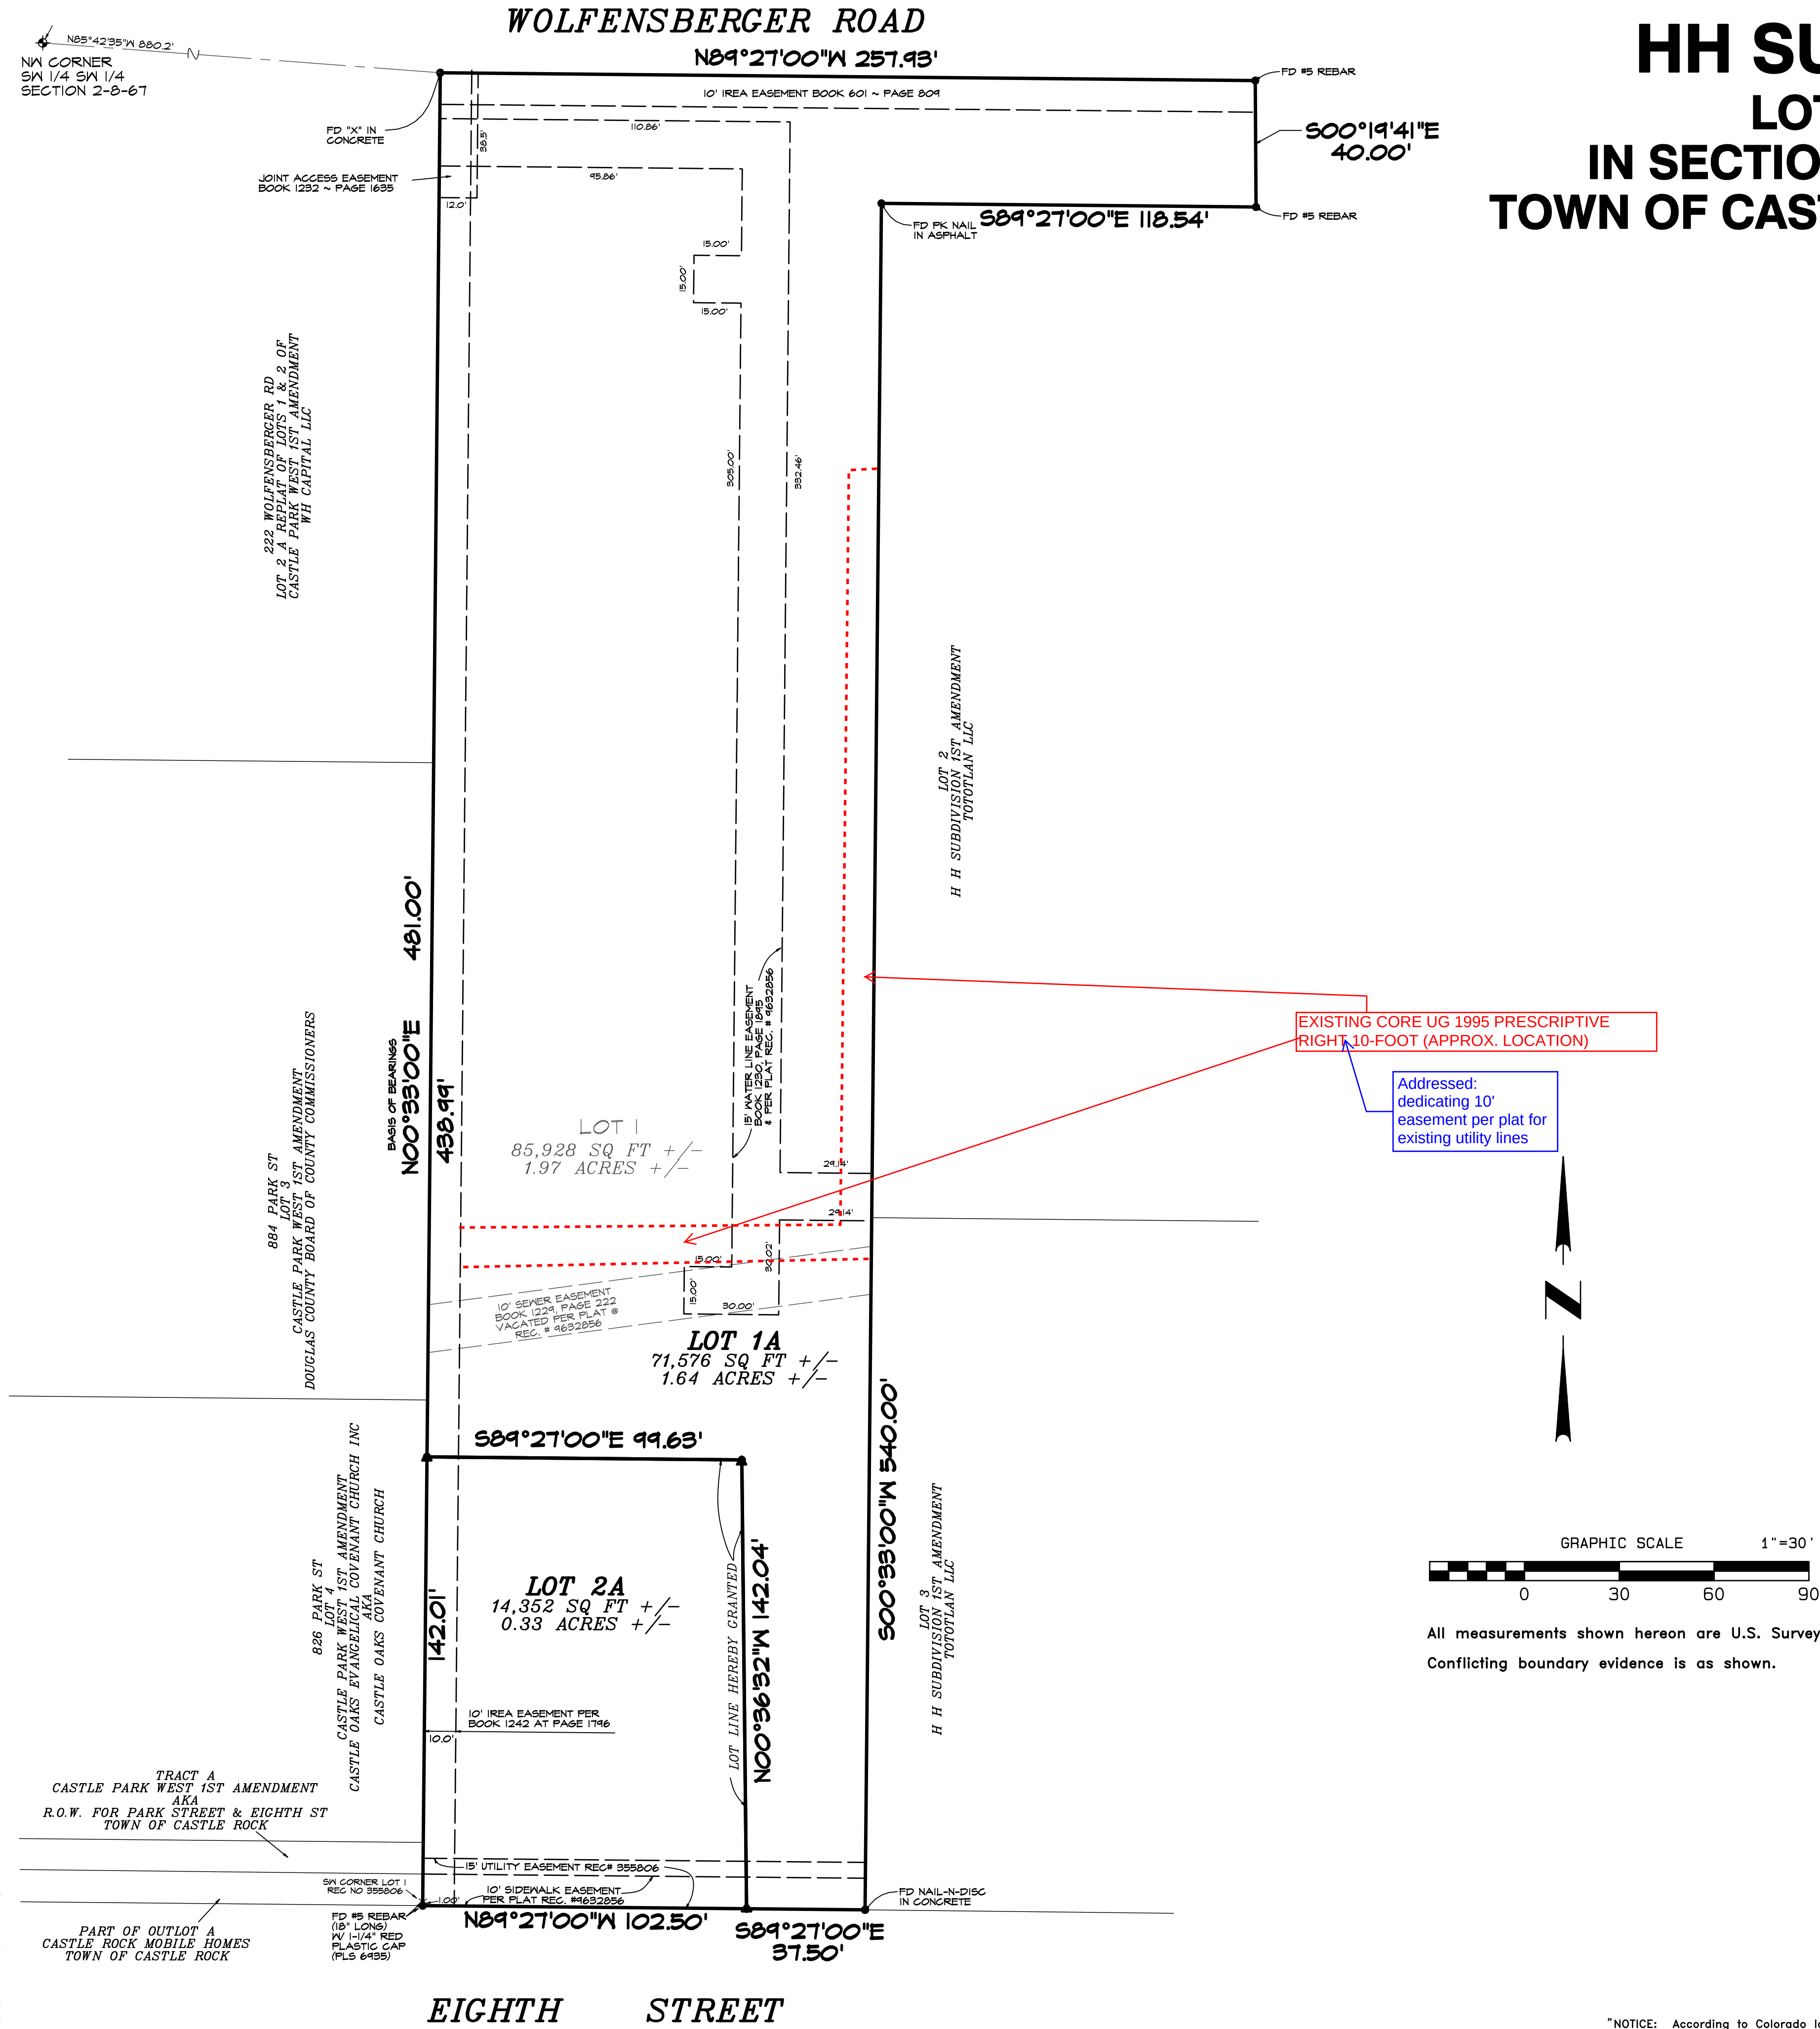

EXISTING CORE UG 1995 PRESCRIPTIVE
RIGHT 10-FOOT (APPROX. LOCATION)

Addressed:
dedicating 10'
easement per plat for
existing utility lines

- LEGEND:
- ▲ Set 24" Rebar W/ 1 - 1/2" Red Plastic Cap (LS36570) on 24" Long #5 Rebar.
 - Property Corner Found as noted.
 - Property Line As shown.
 - - - Existing Property Line Hereby Vacated. As shown.
 - - - Adjacent Property Line As shown.
 - - - Existing Easement Line As noted.

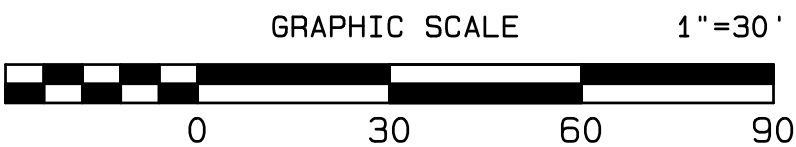

All measurements shown hereon are U.S. Survey Feet.
Conflicting boundary evidence is as shown.

REVISIONS		PROJECT NO. PL22--	
DAVID E. ARCHER & ASSOCIATES, INC. LAND DEVELOPMENT CONSULTING SURVEYING & ENGINEERING PHONE (303) 688-4642 105 WILCOX ST., CASTLE ROCK, COLORADO 80104		TITLE HH SUBDIVISION-SECOND AMENDMENT IN SECTION 2, TOWNSHIP 8 SOUTH, RANGE 67 WEST, 6th P.M., TOWN OF CASTLE ROCK, COUNTY OF DOUGLAS, STATE OF COLORADO.	
DATE 12-02-22 BY DPM APVD.		CLIENT CASTLE OAKS CHURCH	
Sheet 2 of 2		JOB NUMBER 21-1548	

"NOTICE: According to Colorado law you must commence any legal action based upon any defect in this survey within three years after you first discover such defect. In no event, may any action based upon any defect in this survey be commenced more than ten years from the date of the certification shown hereon."

C:\p\working\2021\211548\HH SUBDIVISION-SECOND AMENDMENT\PL22-1548.dwg
PLOT DATE 02/13/2022 13:35:22