



HH SUBDIVISION - SECOND AMENDMENT
LOT 1, H H SUBDIVISION - SECOND AMENDMENT
IN SECTION 2, TOWNSHIP 8 SOUTH, RANGE 67 WEST, 6th P.M.,
TOWN OF CASTLE ROCK, COUNTY OF DOUGLAS, STATE OF COLORADO

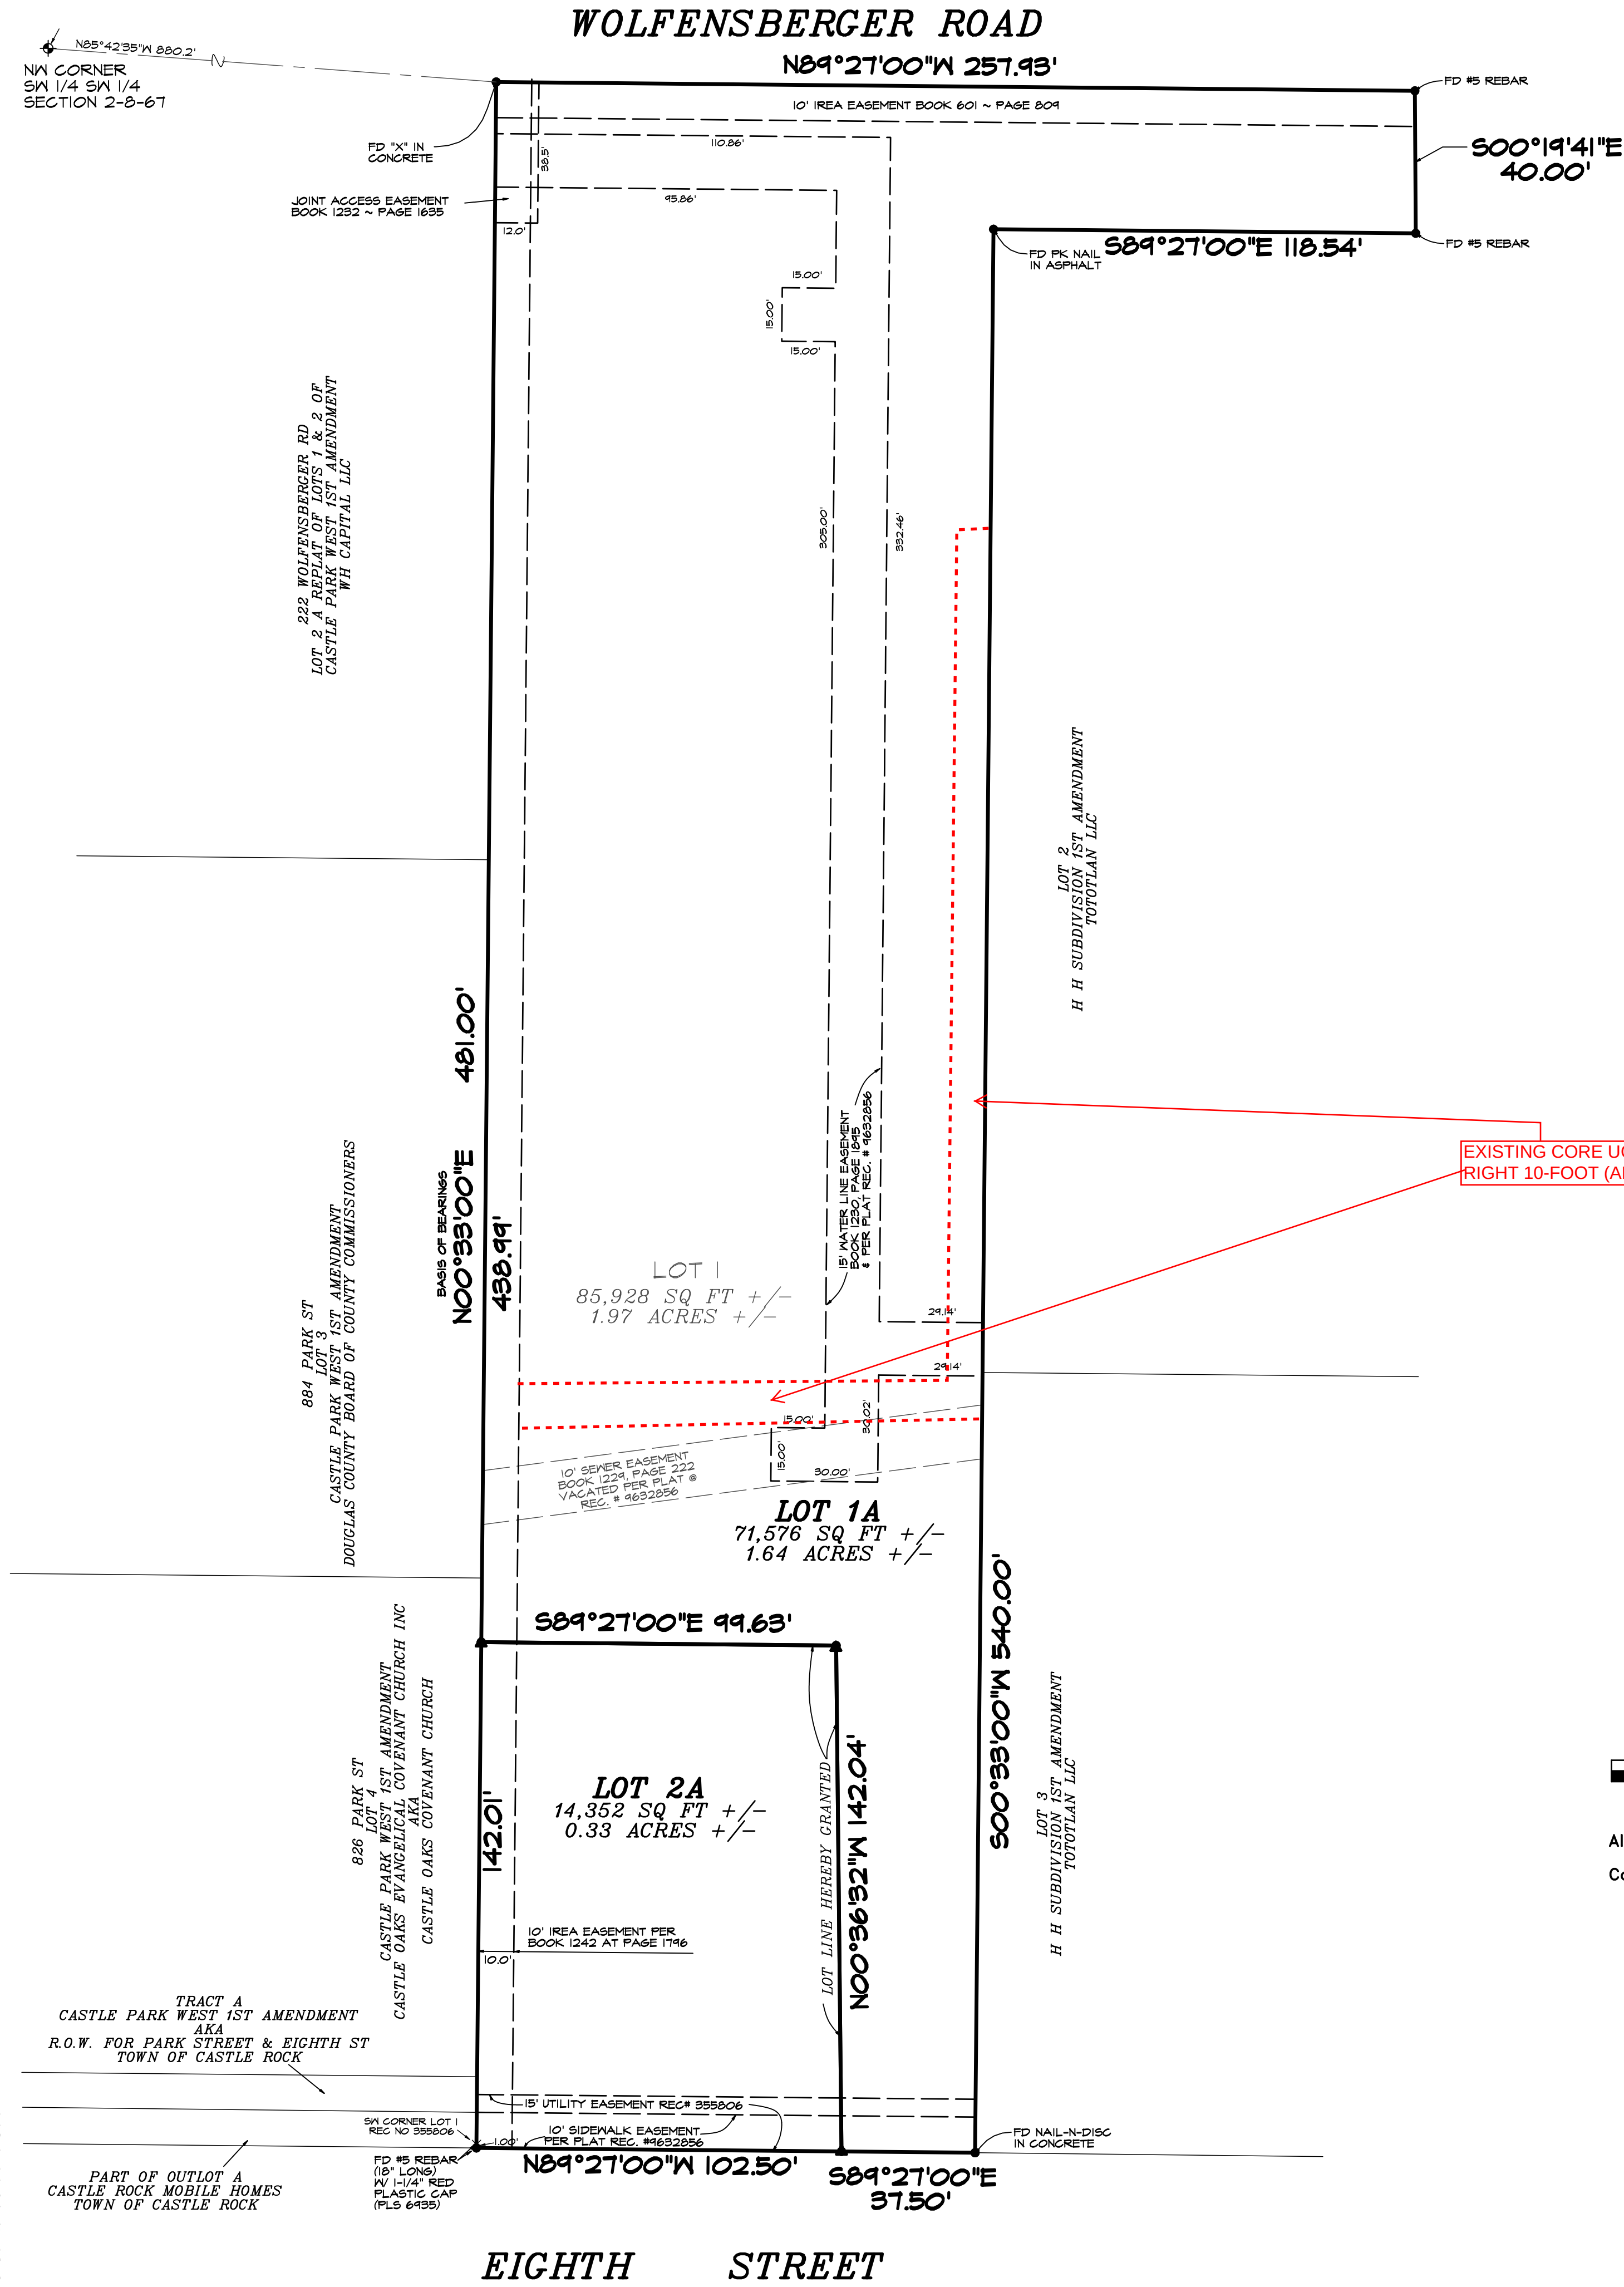

EXISTING CORE UG 1995 PRESCRIPTIVE
RIGHT 10-FOOT (APPROX. LOCATION)

- LEGEND:
- ▲ Set 24" Rebar W/ 1 - 1/2" Red Plastic Cap (LS36570) on 24" Long #5 Rebar.
 - Property Corner Found as noted.
 - Property Line As shown.
 - - - Existing Property Line Hereby Vacated. As shown.
 - - - Adjacent Property Line As shown.
 - - - Existing Easement Line As noted.

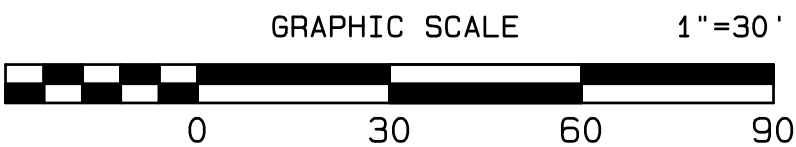

All measurements shown hereon are U.S. Survey Feet.
Conflicting boundary evidence is as shown.

REVISIONS		 DAVID E. ARCHER & ASSOCIATES, INC. LAND DEVELOPMENT CONSULTING SURVEYING & ENGINEERING PHONE (303) 688-4642 105 WILCOX ST. CASTLE ROCK, COLORADO 80104		TITLE	
				HH SUBDIVISION-SECOND AMENDMENT	
				SCALE	IN SECTION 2, TOWNSHIP 6 SOUTH, RANGE 67 WEST, 6th P.M. TOWN OF CASTLE ROCK, COUNTY OF DOUGLAS, STATE OF COLORADO
				DATE	
				DRAWN BY	CLIENT
				APPROVED	
					JOB NUMBER
				Sheet	

"NOTICE: According to Colorado law you must commence any legal action based upon any defect in this survey within three years after you first discover such defect. In no event, may any action based upon any defect in this survey be commenced more than ten years from the date of the certification shown hereon."

C:\p\working\2022\1548\HH SUBDIVISION-SECOND AMENDMENT\PL22-1548.dwg
PLOT DATE 02/13/2022 13:35:22